

CERTIFIED LAND CORNER RESTORATION

Index No. Y-12



State of Wisconsin } ss.
County of Oneida

History of original corner establishment:
No records of any previous surveys.
Wilderness Survey ran traverses and computations for subdivision of Section 33.

I, Phillip T. Hansen, do hereby certify that on the 16th day of November, 1978, I ~~have~~ established ~~the~~ SE 1/16 corner of Section 33 Township 38, North, Range 9 East, Fourth Principal Meridian, as described hereon; and that from this evidence I established a new monument and accessories as described hereon to perpetuate the original location of this corner.

Resident witnesses:

Glen Barker
Jim Claffin
Herb Wagoner

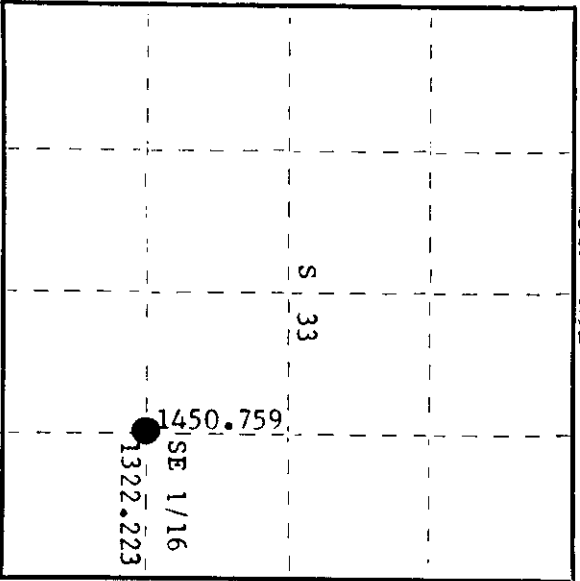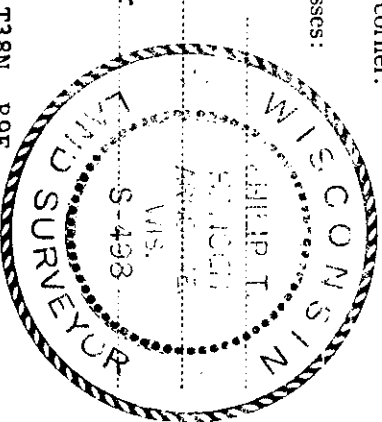

○ = Corner monument restored.

380933/0/0

Description of corner evidence found:
No evidence of any corner recovered. Using controls of Wilderness Survey for subdivision of section 33, which was obtained from them, computed distance and bearings of the EC 1/16. Corner sets N 89° 33' 01" W 1322.223 feet from S 1/16, section 33 and 34 and S 13° 10' 42" W, 1450.759 feet from the EC 1/16 section 33.

Description of monument and accessories I established to perpetuate the original location of this corner.

Set a 1 1/2" iron pipe with 2" brass cap projecting 18" - stamped: Someone's BT, 8" Maple, scribed SE 1/16 BT, bears N 88° W, 44.52'. Marked NBT - Maple 8" N84° W, 63.55', scribed 1/16 BT.

S498
T38N R9E
SE 1/16 S 33
CFI-1978

Dated at Rhinelander, Wis., this 4th day of December, 1978.

Signature: Phillip T. Hansen Title Registered Land Surveyor Registration No. S-498
(County Surveyor, Registered Land Surveyor, or other duly authorized official)

Office of Register of Deeds, County of Oneida.
Instrument was filed in this office for record on the 16th day of January, 1979 at 10:00 o'clock P.M.

Doree Bernice Kuehn
(Register of Deeds)

By: _____ Deputy