

CERTIFIED LAND CORNER RESTORATION

Index No. **A-18**



State of Wisconsin }
County of Oneida } ss.

I Philip P. Jansen, do hereby certify that on the 11th day of October, 1979, I found evidence of the corner of the section between Township 37-38, North, Range 2, West, Fourth Principal Meridian, as described hereon; and that from this evidence I established a new monument and accessories as described hereon to perpetuate the original location of this corner.

Resident witnesses:

JIM STARLIN

Harb - over

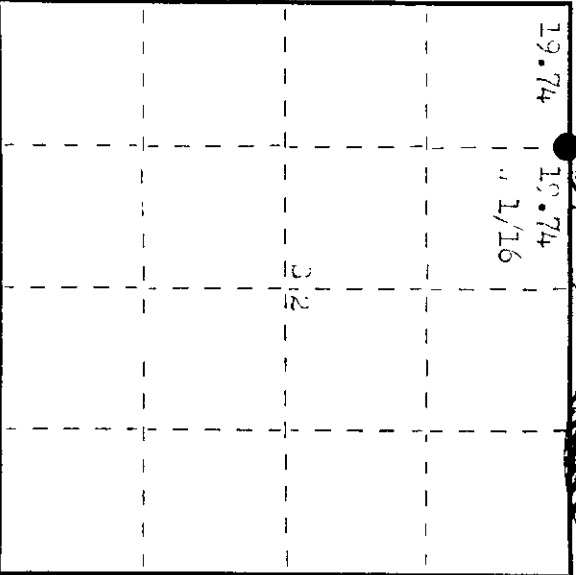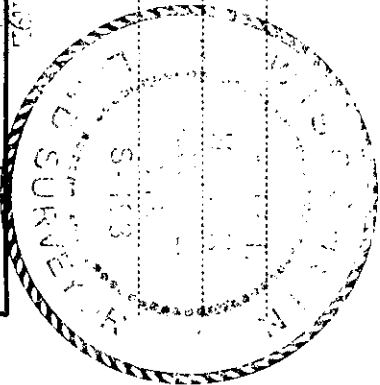

○ = Corner monument restored.

CERTIFIED LAND CORNER RESTORATION

History of original corner establishment:

Corner established by J. J. Jansen, in 1950. A wooden line post (0.40" dia) 2 1/2' high of 78.25 chains to corner and 1/2" dia of section corner 249.25' and 2' proportioned his race to determine 1/16, set 1/16 at 19.74 chains equidistant between 1/4 and section corner.
Set iron pipe and marked 1075 - red line 1" x 3/8" x 1.50g chains and red line 1" x 3/8" x 1.08 chains.

Description of corner evidence found:


Description of monument and accessories I established to perpetuate the original location of this corner.

Monument was recovered in good condition and found in place. In addition, I accessories established.


Signature Philip P. Jansen Title Registered Land Surveyor Registration No. 498
(County Surveyor, Registered Land Surveyor or other duly authorized official)

Office of Register of Deeds, County of Oneida. I hereby certify that the within instrument was filed in this office for record on the 2nd day of December, 1976 at 9:30 o'clock M.

Dorcas Virginia Kuehn
(Register of Deeds)

By: _____ Deputy

3809 350030