

CERTIFIED LAND CORNER RESTORATION

Index No. 5-13

State of Wisconsin }
 County of Oneida } ss.

I William E. Badow, do hereby certify that on the 24th day of April, 1981, I found evidence of the meander corner of the East line of Section 15, Township 38, North, Range 10 East, Fourth Principal Meridian, as described hereon; and that from this evidence I established a new monument and accessories as described hereon to perpetuate the original location of this corner.

Resident witnesses:

History of original corner establishment:



Original survey by William Daugherty in 1865. North between Sections 15 & 16 56.92 chains to lake. Set post.
 BT's
 Birch 16" S 21 W 16 links
 Birch 10" S 50 E 27 links

Description of corner evidence found:

Found a scribed wood post and 1 1/4" iron pipe. N. Kowinski recovered a wood post in 1957

Description of monument and accessories I established to perpetuate the original location of this corner.

Iron pipe and wood post remain in place and one old BT. Made 2
 Old BT. Tam. 10" N 64 W 29.0'
 New BT's Tam. 10" S15E 13.8'
 Tam. 10" S 50 W 34.2'
 Distances are to center of trees.

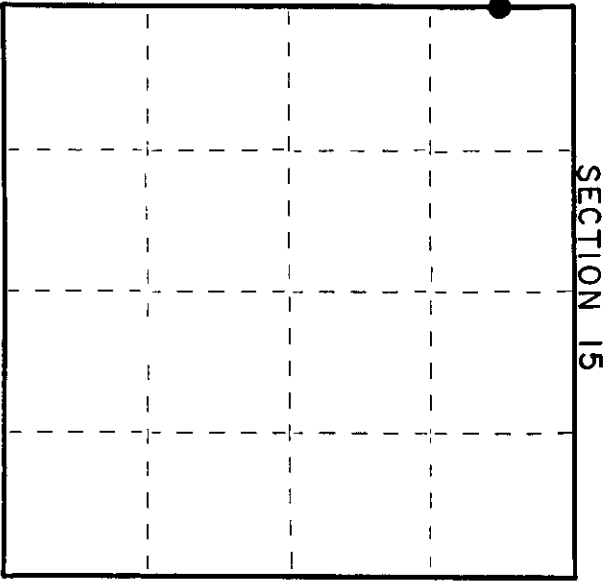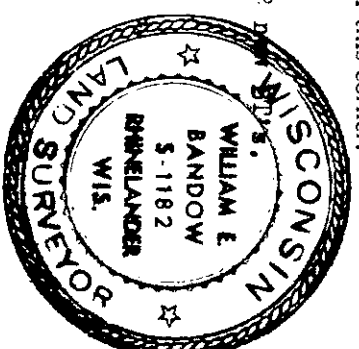

● = Corner monument restored.

Dated at Rhineland, Wis., this 28th day of April, 1981.

Signature William E. Badow Title Registered Land Surveyor Registration No. S. 1182
 (County Surveyor, Registered Land Surveyor, or other duly authorized official)

Office of Register of Deeds, County of Oneida
 instrument was filed in this office for record on the 12 day of June, 1981
 at 5:00 o'clock A. M.

By Doris Novak (Register of Deeds)
Deputy