

CERTIFIED LAND CORNER RESTORATION

Index No. U-13

State of Wisconsin



County of Oncida } ss.

I Philip T. Hansen, do hereby certify that on the 25th day of October, 1977, I found evidence of the S 1/4 Sec. 27 & 28 corner of Sec. 27 & 28 Township 38, North, Range 10 East, Fourth Principal Meridian, as described hereon; and that from this evidence I established a new monument and accessories as described hereon to perpetuate the original location of this corner.

Resident witnesses:

Mr. J. J. Miller

Harb. Jacobs

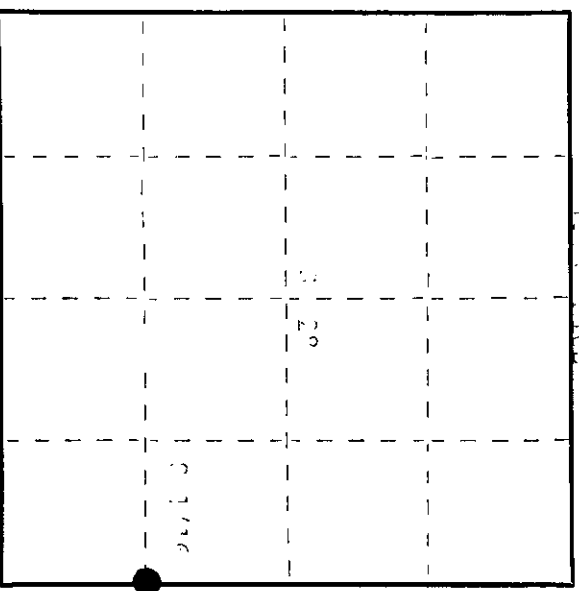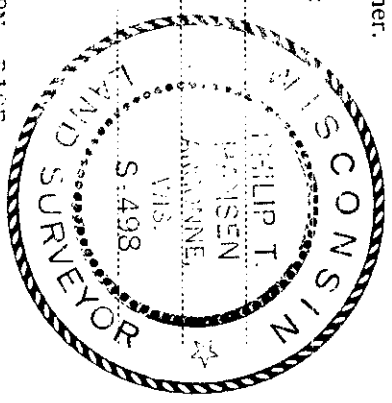

○ = Corner monument restored.

History of original corner establishment:
Corner established by T. Loftus, R. Fred Surveyor, in 1975.
No record of P.T. of P.S. filed.

Description of corner evidence found:

Recovered 2 1/2 inch diameter 1 1/2 inch deep iron pipe with 200 Above ground. 24 attached.
Description of monument and accessories I established to perpetuate the original location of this corner.

Monument 1 1/2 inch diameter 1 1/2 inch deep iron pipe with 200 Above ground. 24 attached.

Dated at Plainfield, Wis., this 24th day of November, 1977.

Signature Philip T. Hansen Title Registered Land Surveyor Registration No. 498
(County Surveyor, Registered Land Surveyor, or other duly authorized official)

Office of Register of Deeds, County of Oncida, I hereby certify that the within instrument was filed in this office for record on the 11th day of December, 1977 at 11:00 o'clock A. M.

Thomas George Kuehn
(Register of Deeds)

By Joseph M. Boerner Deputy

381028/000