

CERTIFIED LAND CORNER RESTORATION

Index No. **V-6**

State of Wisconsin

County of Oneida } ss.


I Phillip T. Hansen, do hereby certify that on the 18th day of May, 19 77, I found evidence of the W 1/16 corner of Sec. 29 & 32 Township 38, North, Range 10 East, Fourth Principal Meridian,

as described hereon; and that from this evidence I established a new monument and accessories as described hereon to perpetuate the original location of this corner.

Resident witnesses:

Jim Claflin

Herb Wagoner

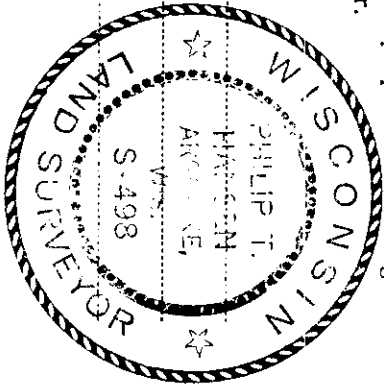


History of original corner establishment:
Corner established by N. Loftus, Ripco Surveyor. Ran random line S86°E from Section Corner 30, 29, 31 & 32 bearing S 0° 50' E, a distance of 82.41 chains to close out 1.51 chains south of Section Corner 28, 29, 32 & 33. Set N 1/4 corner at 41.20 chains. Set W 1/16 corner at 20.60 chains. Corrected bearing N 89° 47' E.

Description of corner evidence found:

Recovered 1" iron pipe with 2" brass cap, stamped:
Monument projects 30" above ground.
Monument recovered in excellent condition.
No evidence of OBTFs established

T38N R10E
W 1/16 S 29
S 32
RIPCO

Description of monument and accessories I established to perpetuate the original location of this corner.
As the monument was recovered in excellent condition, it was left in place.
NBTFs - Aspen 6" S30°W 39.7 links.
Aspen 6" S60°W 73.3 links, scribed 1/16 BT.

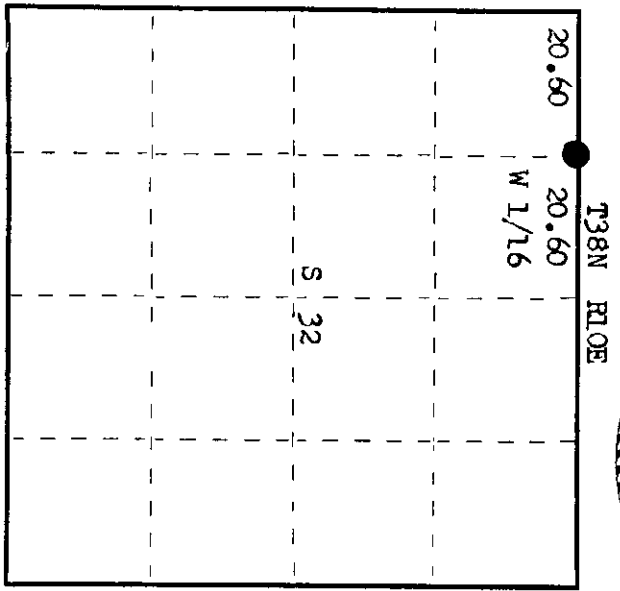

○ = Corner monument restored.

Dated at Rhineland, Wis., this 26th day of May, 19 77.

Signature: Phillip T. Hansen Title: Registered Land Surveyor Registration No. S-498
(County Surveyor, Registered Land Surveyor, or other duly authorized official)

Office of Register of Deeds, County of Oneida, YTA day of June, 19 77.
I hereby certify that the within instrument was filed in this office for record on the 30 day of May, 19 77 at 10:30 o'clock A. M.

Doreen Lange Kuehn
(Register of Deeds)

By: _____ Deputy



38102900.38