U.S. PUBLIC LAND SURVEY MONUMENT RECORD


Note: This form is intended and designed to fulfill all requirements of Wisconsin Administrative Code, Chapter A-E 7.08 U.S. Public Land Survey Monument Record (3)(a-i).

(a) CORNER LOCATION 1/4 Cor. of Secs. 13 & 18 Township 39 North Range 4 & 5 East of the 4th P.M.

Town of Minocqua County of Oneida

WISCRS - Oneida County N: 249.143.54 USft E: 133,999.09 USft Datum: NAD 83(2011)

GNSS Method: Real-Time Network **GNSS Control: WISCORS VRS**

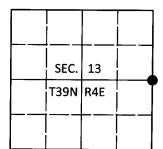

(b) HISTORY OF ORIGINAL CORNER ESTABLISHMENT

Original Surveyor: Alfred Millard

Original Accessories:

Date of Survey Commenced: Sep., 1860

Completed: Sep., 1860

Tamarack 10 N80°W, 13 lks. W. Pine 12 S30°E, 21 lks.


(b)(f)(g)(h) Description of monument found at this corner and if it was accepted, state all evidence (material, testimonial, occupational, plats, records, other monuments) used as a basis for accepting. If not accepted or if nothing was found, state evidence used as basis for establishing location. If re-established through lost corner proportionate methods, indicate all monuments, distances and directions used to establish. Indicate type of monument and sign post found or set.

May 6, 1926: Notes by D.S. Burnett in Old Fieldbook 28 on page 26 indicate he set a wood post from the remains of the GLO trees and made new accessories: w. pine stump 18 S63'E, 32 lks.; w. pine stump 20 N5'E, 36 lks.

May 26, 2017: Jeff Austin visited the corner and recovered a perpetuation of Burnett's monument, a 2-1/2" diam. aluminum pipe with a 3-1/4" diam. Oneida Co. aluminum cap projecting 6" above the ground surface. The monument appears to have been set by James G. Griffin, RLS. The remains of both of Burnett's pine stumps and a stump hole from the GLO pine were found. Accessories were found or established as shown below. A white vinyl sign post was found West, 1 ft.

The coordinate value shown has been verified by at least one of the following methods: 1) comparison to a previously GPS determined published value; 2) the value is the average of two or more GPS observations at a markedly different time; 3) one or more distances were measured back to the GPS observed corner from temporary GPS observed offset locations.

(c)(d)(e) Plan view of corner with ties to at least 4 witness monuments. If in disagreement with previously established corner, show the distances between the two corners and also indicate the ties to the disputed.

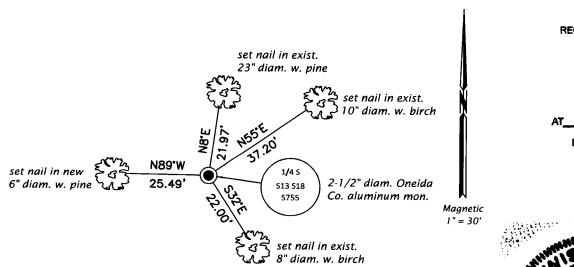

(i) I, Michael J. Romportl, Professional Land Surveyor No. S-1624, hereby certify that the corner location on this record was determined by me or under my direction and control and that this U.S. Public Land Survey Monument Record is correct and complete to the best of my knowledge and belief.



REGISTER OF DEEDS OFFICE ONEIDA COUNT JUL 112017 O'CLOCK KYLE J. FRANSON REGISTER OF DEEDS



3904132000 (INDEX NO. L-25)