

U.S. PUBLIC LAND SURVEY MONUMENT RECORD

This form is intended and designed to fulfill all requirements of Wisconsin Administrative Code, Chapter A-E 7.08 U.S. Public Land Survey Monument Record (3) (a)(b)(c)(d)(e)(f)(g)(h)(i).

The coordinate value shown has been verified by at least one of the following methods: 1) Comparison to a previously GNSS determined published value; 2) The value is the average of two or more GNSS observations at a markedly different time; 3) One or more distances were measured back to the GNSS observed corner from temporary GNSS observed offset locations.

Oneida County
Land Information Office
Filed
10/10/2025


A-E 7.08(3)(a) Identity of the corner:

Meander Corner Section 19	WISCRS - Oneida County
Township 39 North	N: 241415.99
Range 5 East	E: 138255.39
Town of Minocqua	Datum: NAD 83 (2011)
County of Oneida	GNSS Method: WISCRS VRS Direct Observation

Original Corner Information:

Original Surveyor: Alex Anderson	Original B.T.'s: Birch 5" - S15°W, 77 links
Date of Survey: September, 1863.	No Other Trees Near

Corner ID: 3905190009

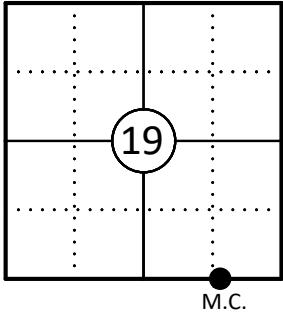


A-E 7.08(3)(b)(e)(f)(g) Describe any record evidence, monument evidence, occupational evidence, testimonial evidence or any other material evidence considered. Describe any discrepancy between the corner restored and any previously established location. State whether the corners was restored through acceptance of obliterated evidence, a found perpetuated location, or determined by proportionate methods.

04/02/1975 Northwoods survey notes indicate "Set M.C. 2in I.P. & scribed red top, 8in W. Pine N36°E, 7.9ft" near the easterly shoreline of Squirrel Lake and on line with the the meander corner across the lake and the northeast corner of Section 30.


07/17/1975 Inman Engineering of Woodruff, WI shows a 2" dia. iron pipe found on the south line of Section 19 near the easterly shoreline of Squirrel Lake (See OCSM No. B6809).

09/18/2025 I found a 2" dia. iron pipe near the easterly shoreline of Squirrel Lake as well as the bearing tree made by Northwoods Surveyors in 1975. This corner fit well with the location shown on OCSM No. B6809 and other surveys in this area. I replaced the iron pipe with a 3" dia. Oneida County aluminum capped monument stamped to identify the corner and set flush with the ground. I set two iron pipes and made two bearing trees to witness the corner as shown below.


A-E 7.08(3)(c)(d)(e)(h) Plan view of corner with ties to at least four witnesses. If in disagreement with previously established corner, show the distances between the two corners and also indicate the tie to the disputed corner. Distances and directions to other PLSS used as evidence or for proportioning.

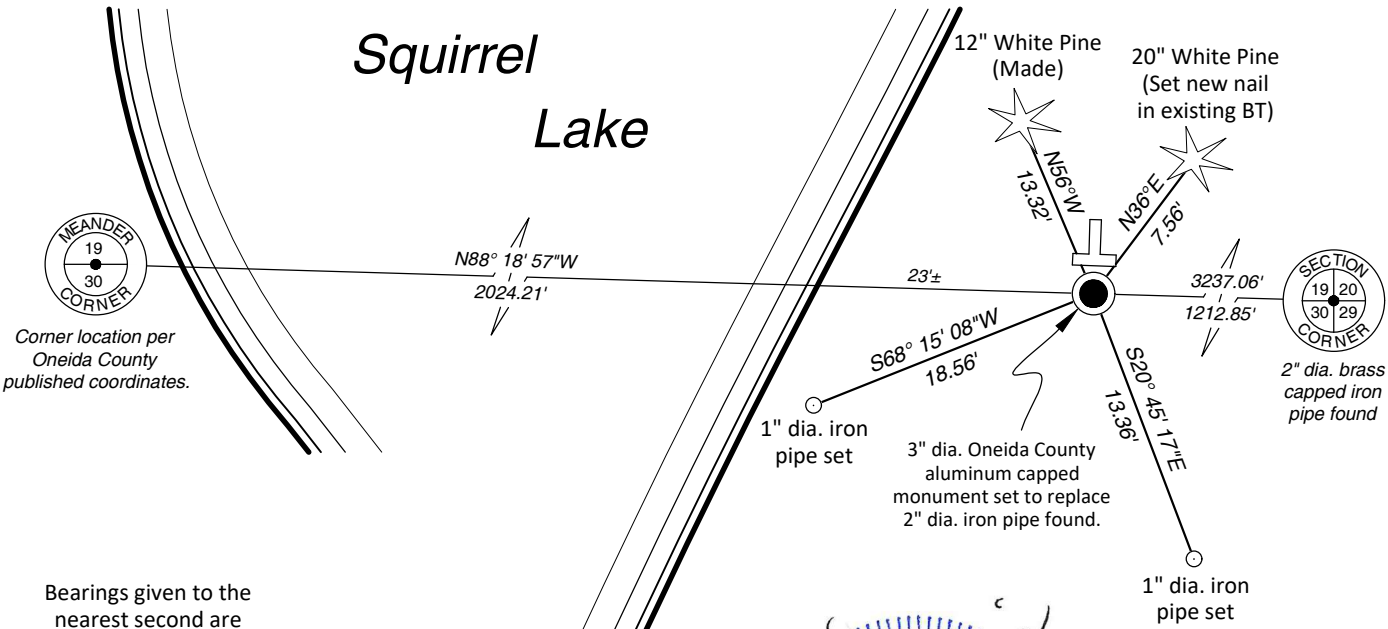

Bearings given to the nearest second are Oneida County Grid all other bearings are magnetic

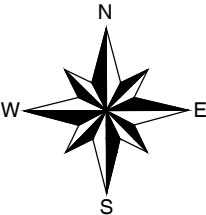

- * Vinyl "T" post 0.8' north of corner.
- * Distances to bearing trees are to nail in side with BT tag on tree.
- * Sketch is not to scale

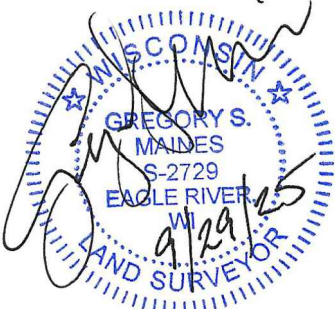

A-E 7.08(3)(i) - Certification

I, Gregory S. Maines, Professional Land Surveyor No. 2729, hereby certify that the corner location on this record was referenced by me or under my direction and control and that this U.S. Public Land Survey Monument Record is complete to the best of my knowledge and belief. REF: 2023328-8

Index No.: