


U. S. PUBLIC LAND SURVEY MONUMENT RECORD

Note: This form is intended and designed to fulfill all requirements of Wisconsin Administrative Code, Chapter A-E 7.08 U.S. Public Land Survey Monument Record (3)(a)(b)(c)(d)(e)(f)(g)(h)(i). An additional sheet may be added if necessary to conform with said requirements.

(a) Corner location: Township 39 North
 Range 5 East
 Town of Minocqua
 Oneida County, Wisconsin

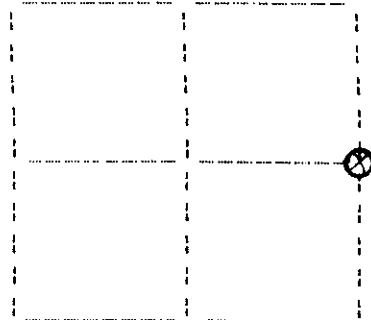

Section 21

(b)(f)(g)(h) Description of monument found at this corner and if it was accepted, state all evidence (material, testimonial, occupational, plats, records, other monuments) used as a basis for accepting. If not accepted or if nothing was found, state evidence used as basis for establishing location. If reestablished through lost corner proportionate methods, indicate all monuments, distances and directions used to establish. Indicate type of monument found or set and sign post.

September, 1863: Alexander Anderson notes the following: 40.00 set 1/4 sec. post: tamarac 10 S62°W, 13 lks.; cedar 8 N73°E, 9 lks.


December 18, 1934: Hall page 212 notes the following: 20.00 fall about .30 W of orig. 1/4 S. identified by both bearings. marks ok. the NE tree is a cedar leaning E. distance between brngs. meas. 26 lks. (rec. 22) set new post (.13 from the tamarac) new: cedar 9° S19°E, .085.

August 19, 1990: I found and accepted a 4" dia. wood post point below the bog surface. I replaced said post with a 2-1/2" dia. aluminum cap on a 72" long aluminum post stamped as shown below. I found the following witnesses: rotted stump S59°W, 9.8 feet; cedar (dying) 12" S17°E, 5.9 feet. I established the following witnesses: set nail in tamarack 7" N19°E, 16.52 feet; set nail in balsam 4" S35°E, 22.66 feet; set nail in balsam 3" S17°E, 7.35 feet; set nail in balsam 3" S25°W, 9.32 feet; set plastic sign post north 1 foot; a large beaver dam bears NE 30 feet more or less.

(c)(d)(e) Plan view of corner with ties to at least four witness monuments. If in disagreement with previously established corner, show the distances between the two corners and also indicate the ties to the disputed corner.

1. nail in tamarack 7" N19E, 16.52 feet.
2. nail in balsam 4" S35E, 22.66 feet.
3. nail in balsam 3" S17E, 7.35 feet.
4. nail in balsam 3" S25W, 9.32 feet.

(not to scale)

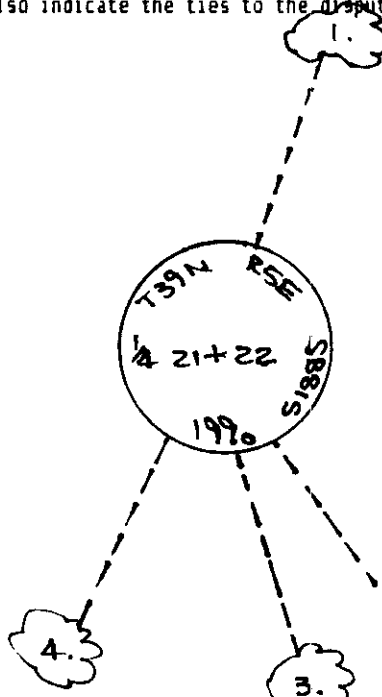

REGISTER OF DEEDS OFFICE
 ONEIDA COUNTY, WIS
FILED
 SEP 3 1990
 At _____ O'Clock _____ M
THOMAS H. LEIGHTON
 REGISTER OF DEEDS

I, Jeffrey W. Austin, Registered Land Surveyor S-1885 certify that the corner location on this record was determined by me or under my direction and control and that this U.S. Public Land Survey Monument Record is correct and complete to the best of my knowledge and belief.

Jeffrey W. Austin
 Signature _____ Date SEPTEMBER 3, 1990



Index no. P-13

3905212000

P-13