U.S. PUBLIC LAND SURVEY MONUMENT RECORD

Note: This form is intended and designed to fulfill all requirements of the Wisconsin Administrative Code, Chapter A-E 7.08 U.S. Public Land MonumentRecord (3)(a)(b)(c)(d)(e)(f)(g)(h)(i). An additional sheet may be added if necessary to conform with said requirements.

(a) CORNER LOCATION: S. M.C. east line of Section 5

Township 39 North Range 6 East Town of Minocqua County of Oneida

WISCRS - Oneida County North: 257768.799 USft East: 175994.828 USft Latitude: 45° 53' 33.98337" N Longitude: 89° 45' 23.46421" W

Datum: NAD 83(2011) GNSS Method: RTK - Offset GNSS Control: WISCORS VRS Record North: 257769.057 USft Record East: 175994.749 USft Record Datum: NAD 83(1991)

(b) HISTORY OF ORIGINAL CORNER ESTABLISHMENT

Original Surveyor: Alexander Anderson Date of Survey: Commenced Oct. 13, 1863 Completed Oct. 23, 1863


Original B.T.'S: Corner not set as part of the U.S.P.L.S.

REGISTER OF DEEDS OFFICE ONEIDA COUNTY **FILED**

JUN 01 2017

O'CLOCK KYLE J. FRANSON REGISTER OF DEEDS

(RECORDING AREA)

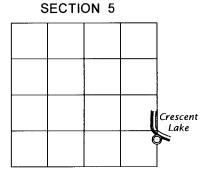


(f)(g)(h) DESCRIPTION OF MONUMENT FOUND AT THIS CORNER AND IF IT WAS ACCEPTED, STATE ALL EVIDENCE (MATERIAL, TESTIMONIAL, OCCUPATIONAL, PLATS, RECORD, OTHER MONUMENTS) USED AS A BASIS FOR ESTABLISHING LOCATION. IF NOT ACCEPTED OR IF NOTHING WAS FOUND, STATE EVIDENCE USED AS BASIS FOR ESTABLISHING LOCATION. IF REESTABLISHED THROUGH LOST CORNER PROPORTIONATE METHODS, INDICATE ALL MONUMENTS, DISTANCES AND DIRECTIONS USED TO ESTABLISH. INDICATE TYPE OF MONUMENT AND SIGN POST FOUND OR SET.

January 29, 1959 - E. F. Kowalke, RLS No. 403, map of survey, 6-B-16, for a survey in the East Half of Section 5, T39N, R6E, filed in the county surveyor's office as B6026, and accompanying field notes in Kowalke Book 19, page 59, shows he set an iron pipe for the south meander corner on a straight line between the southeast and east quarter corner of Section 5, referenced by a Birch 10" N 54°E, 6.3' and a N. Pine 5" S 4 1/2°E, 24.4'

May 11, 2017 - James D. Rein, PLS No. 1234, we set an Oneida County capped 2.4" x 30" long aluminum monument to replace a 1.4" dia. x 27" long iron pipe found in place. Based on published county coordinate data, this monument is positioned within 0.3 feet of a straight line between the controlling corners and has been accepted by all subsequent surveyors, in both Sections 4 and 5, as marking the section line. We made new reference ties to the corner as shion in the plan.

The coordinate value shown has been verified by at least one of the following methods: 1) comparison to a previously GPS determined published value; 2) the value is the average of two or more GPS observations at a markedly different time; 3) one or more distances were measured back to the GPS observed corner from temporary GPS observed offset locations.

(c)(d)(e) PLAN VIEW OF CORNER WITH TIES TO AT LEAST 4 WITNESS MONUMENTS. IF IN DISAGREEMENT WITH PREVIOUSLY ESTABLISHED CORNER, SHOW THE DISTANCE BETWEEN THE TWO CORNERS AND ALSO INDICATE THE TIES TO THE DISPUTED CORNER.

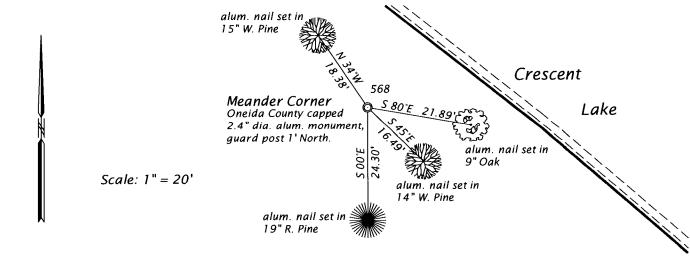

(i) I, JAMES D. REIN, PROFESSIONAL LAND SURVEYOR NO. S-1234 HEREBY CERTIFY THAT THE CORNER LOCATION ON THIS RECORD WAS DETERMINED BY ME OR UNDER MY DIRECTION AND CONTROL AND THAT THIS U.S. PUBLIC LAND SURVEY MONUMENT RECORD IS CORRECT AND COMPLETE TO THE BEST OF MY KNOWLEDGE AND

BELIEF.

SIGNATU/RE

DATE

INDEX NO. DE - 9 3906050400

IAMES D REIN

S-1234 MINOCQU WI WO SURVE

