

U.S. PUBLIC LAND SURVEY MONUMENT RECORD

Note: This form is intended and designed to fulfill all requirements of Wisconsin Administrative Code, Chapter A-E 5.02, U.S. Public Land Survey Monument Record (3) (a) (b) (c) (d) (e) (f) (g) (h) (i). An additional sheet may be added if necessary to conform with said requirements.


(a) Corner location: Township 39 North

Range 7 East ~~11~~

Town ~~of Woodruff~~ of Woodruff

County Oneida

2" iron pipe with W.C.D. brass cap

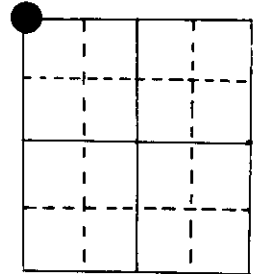

NW cor Section 12

(b) (f) (g) (h) Description of monument found at this corner and if it was accepted, state all evidence (material, testimonial, occupational, plats, records, other monuments) used as a basis for accepting. If not accepted or if nothing was found, state evidence used as basis for establishing location. If reestablished through lost corner proportionate methods, indicate all monuments, distances and directions used to establish.


Original Alex Anderson sept 1863. OBT's Fir 10" N 72°W 8 lks, BW 9" N 2°E 25 lks

Vaughn on 12/27/1900 found cor OK, is 40.65 south of W 1.

Berndt on 12/15/60 set W.C.D pipe for new sec. cor. BT's
 PW 12" S 35°E 0.745 ch
 PN 4" S 50°W 0.105 ch
 PN 4" N 13° W 0.250 ch

I found WCD pipe on 5/24/82 in good condition.
 On 3/8/84 made new BT's PN 8" N 73°E 8.48', PN 12" S 11°E 17.50'

(c) (d) (e) Plan view of corner with ties to at least 4 witness monuments. If in disagreement with previously established corner, show the distances between the two corners and also indicate the ties to the disputed corner.

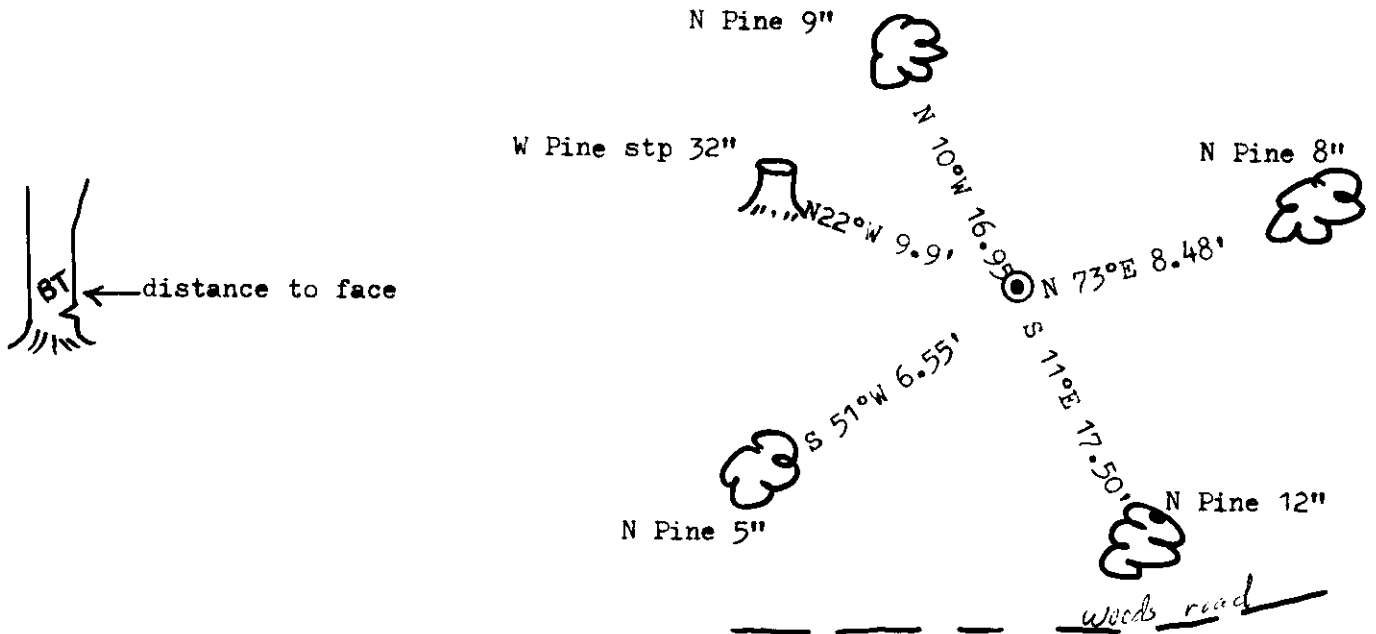

(i) I, Marvin Seymour
 (type or print name) certify that the corner location on this record was determined by me or under my direction and control and that this U.S. Public Land Survey Monument Record is correct and complete to the best of my knowledge and belief.

Marvin E. Seymour April 12, 1984
 Signature Date



3907020000