U.S. PUBLIC LAND SURVEY MONUMENT RECORD

Note: This form is intended and designed to fulfill all requirements of Wisconsin Administrative Code, Chapter A-E 5.02, U.S. Public Land Survey Monument Record (3) (a) (b) (c) (d) (e) (f) (g) (h) (i). An additional sheet may be added if necessary to conform with said requirements.

(a) Corner location: Township 39 North

Range 7 East[redacted]

Town/[redacted] of Woodruff

County Oneida

2" iron pipe with W.C.D. brass cap

EMC

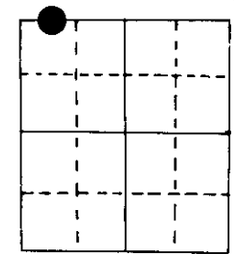

Section 17

(b) (f) (g) (h) Description of monument found at this corner and if it was accepted, state all evidence (material, testimonial, occupational, plats, records, other monuments) used as a basis for accepting. If not accepted or if nothing was found, state evidence used as basis for establishing location. If reestablished through lost corner proportionate methods, indicate all monuments, distances and directions used to establish.

Original Alex Anderson Sept 1863. OBT's Heml 8" S 30½°E 16 lks, Heml 7"N 80½°E 12 lks
At 10.00 ch east of NW 17 and 30.45 ch west of ¼ cor.

Dorr in 12/3/07 found ori g. M.C., OBT's Heml 7" N 80½°E 12, good
other one broken off, marks plain

I found on 9/9/82 a W.C.D. pipe with BT's PN 12" N 58°W 1.35', PN 14" S 30°W 11.23'
Made two more BT's
Pipe probably set by B erndt in 1950's or 60's. Records are gone.

Monument is N 89°16'30"E 608.79' from NW 17
S 89°18'20"W 2119.20' from ¼ cor.

(c) (d) (e) Plan view of corner with ties to at least 4 witness monuments. If in disagreement with previously established corner, show the distances between the two corners and also indicate the ties to the disputed corner.

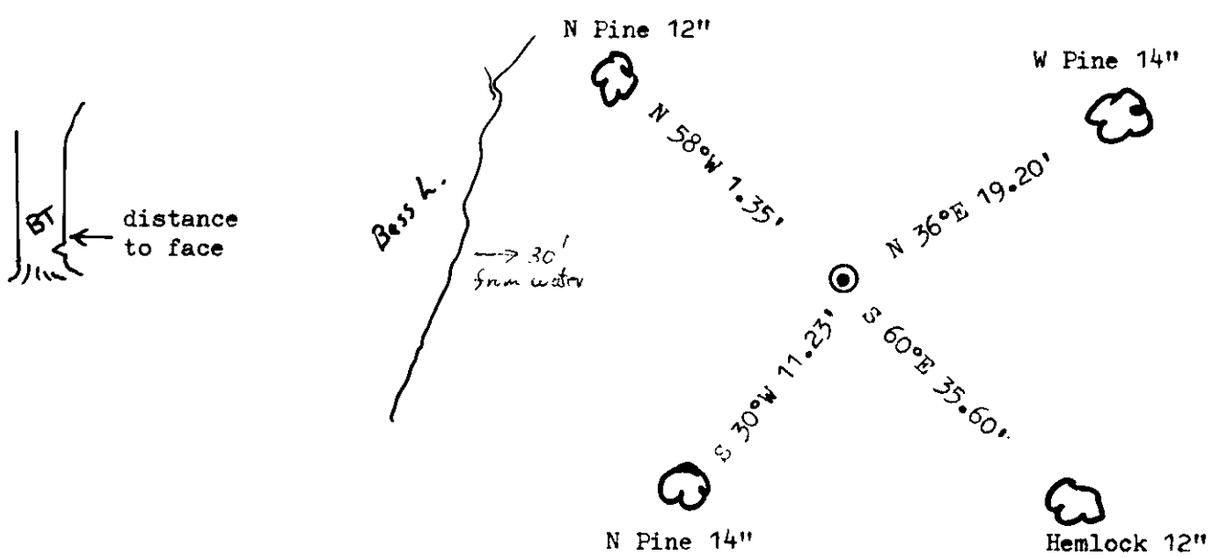

(i) I, Marvin E. Seymour (type or print name) certify that the corner location on this record was determined by me or under my direction and control and that this U.S. Public Land Survey Monument Record is correct and complete to the best of my knowledge and belief.

Marvin E. Seymour — Signature

April 16, 1984 — Date

WISCONSIN LAND SURVEYOR MARVIN E. SEYMOUR S-1412 WOODRUFF, WIS.

Affix seal here

4-5(m)

3907080035