

# U.S. PUBLIC LAND SURVEY MONUMENT RECORD


Note: This form is intended and designed to fulfill all requirements of Wisconsin Administrative Code, Chapter A-E 5.02, U.S. Public Land Survey Monument Record (3) (a) (b) (c) (d) (e) (f) (g) (h) (i). An additional sheet may be added if necessary to conform with said requirements.

(a) Corner location: Township 39 North

Range 7 East ~~11~~

Town/ ~~11~~ of Woodruff

County Oneida

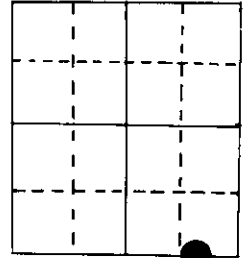

EMC Section 36

2" iron pipe with W.C.D. brass cap


(b) (f) (g) (h) Description of monument found at this corner and if it was accepted, state all evidence (material, testimonial, occupational, plats, records, other monuments) used as a basis for accepting. If not accepted or if nothing was found, state evidence used as basis for establishing location. If reestablished through lost corner proportionate methods, indicate all monuments, distances and directions used to establish.

Original Alex Anderson Sept 1860. OBT's B Ash 12" S 84°E 47 lks, Maple 10" N 65°E 30 lks at 18.60 ch west of SE 36.

Berndt in 1958 set W.C.D. pipe at 18.470 ch west of SE 36  
BT's made E 9" S 32°W 0.070 ch, E 8" N 45°E 0.070 ch

I found on 11/10/80 W.C.D. pipe and Berndt's BT's .  
(5/84) new BT's FB 10" S 40°E 37.44', Basswood 12" N 81°E 43.72'

(c) (d) (e) Plan view of corner with ties to at least 4 witness monuments. If in disagreement with previously established corner, show the distances between the two corners and also indicate the ties to the disputed corner.

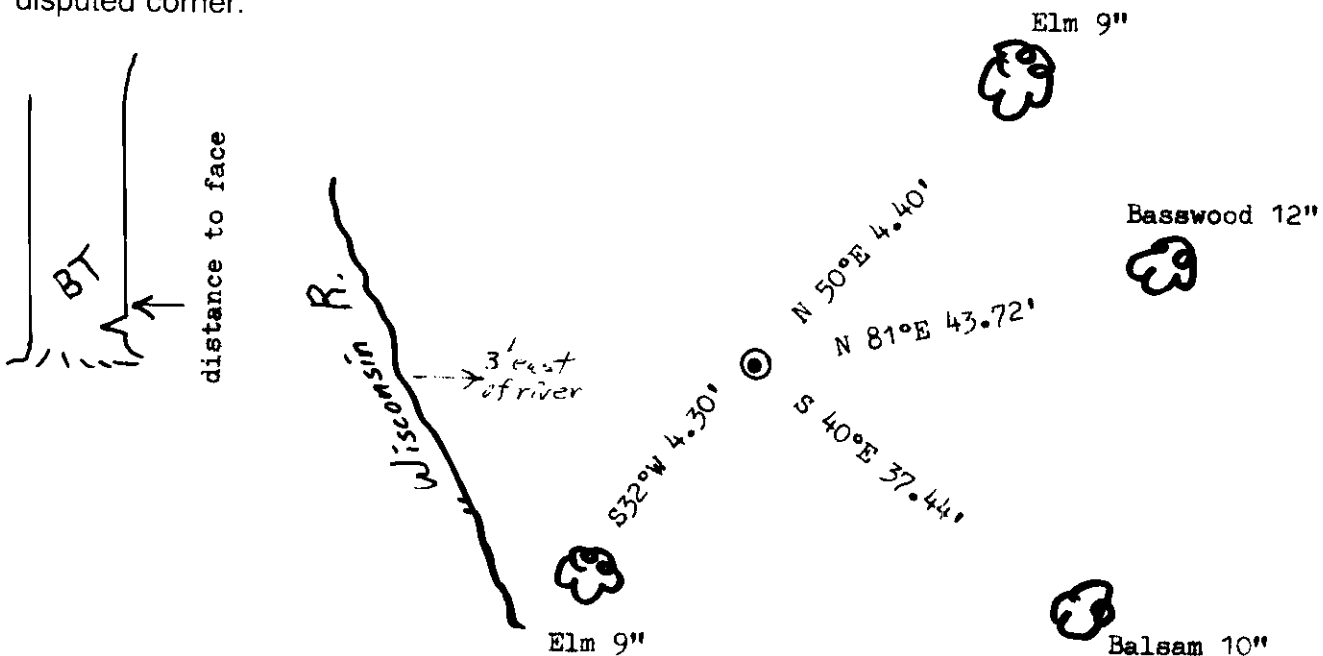

(i) I, Marvin E. Seymour  
(type or print name) certify that the corner location on this record was determined by me or under my direction and control and that this U.S. Public Land Survey Monument Record is correct and complete to the best of my knowledge and belief.

Marvin E. Seymour June 5, 1984  
Signature Date



2-24

3907360008