

U.S. PUBLIC LAND SURVEY MONUMENT RECORD

Note: This form is intended and designed to fulfill all requirements of Wisconsin Administrative Code, Chapter A-E 7.08 U.S. Public Land Survey Monument Record (3) (a) (b) (c) (d) (e) (f) (g) (h) (i). An additional sheet may be added if necessary to conform with said requirements.


(a) Corner location: Township 39 North Corner: West line/Section 12 Wit MC/South Bank-Wisconsin River

Section 12 Range 3 East Original Surveyor: A. Anderson

Town/City/Village Newbold

Original B.T.'s: 12" Bw S05°E 25 lks
6" Aspen S30°W 6 lks

County Oneida

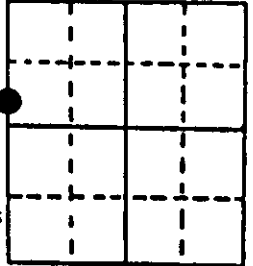


Original Survey Date: July 1863 ● Location

(b) (f) (g) (h) Description of monument found at this corner and if it was accepted, state all evidence (material, testimonial, occupational, plats, records, other monuments) used as a basis for accepting. If not accepted or if nothing was found, state evidence used as basis for establishing location. If reestablished through lost corner proportionate methods, indicate all monuments, distances and directions used to establish. Indicate type of monument found or set and sign post.

Found and accepted an old 2" dia. iron pipe monument with uncapped top 22" above grade at this corner location; I carefully removed the older iron pipe and reset the corner location with a standard 2" dia. by 48" long iron pipe monument with a stamped brass cap 20" above grade, and left the 48" long older monument flat on grade next to new iron pipe monument. I set a standard white poly 'T' corner marker post 1' North of new monument set. All original GLO corner evidence is now obliterated; and based upon record versus current section line measure comparisons, the original MC corner would fall about 12 feet into the Wisconsin River from its south or left bank. In 1938, Wisconsin Valley Improvement Company notes the older 2" iron pipe at the Wit MC corner, at 7.226 chains North of the West 1/4 corner of section 12 and at 6.128 chains South of a Wit MC corner monument on the North/right bank of the Wisconsin River; and also new BTs: 9" Pn stump N60°W 0.530 chains and a 8" Pn stump S60°E 0.227 chains, both now of unreliable origin or reference usage. This recovery was completed Decemr 2, 1997; there were no witnesses.

(c) (d) (e) Plan view of corner with ties to at least 4 witness monuments. If in disagreement with previously established corner, show the distances between the two corners and also indicate the ties to the disputed corner.

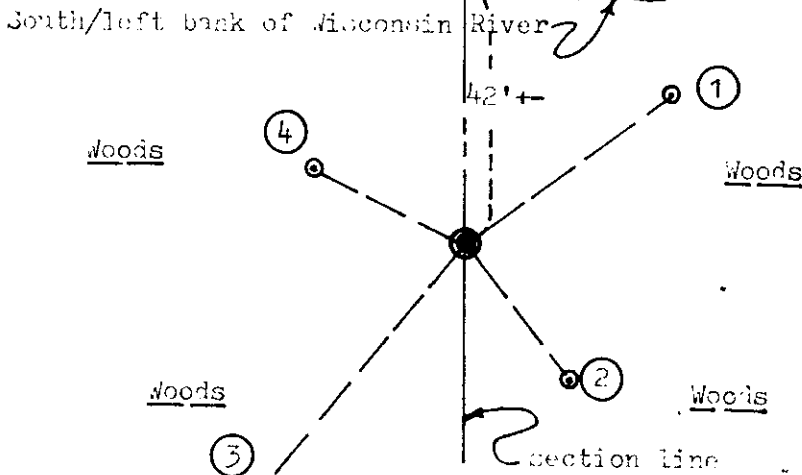

Witness Monument Ties:


- ① New BT 9" Or N54°E 39.69'.
- ② New BT 5" Pw S37°E 26.95'.
- ③ New BT 7" Pw S40°W 49.07'.
- ④ New BT 5" Pw N63°W 26.67'.

Note: Corner is located about 375' North of an existing east/west dirt roadway.

Unless otherwise indicated, all BT witness monument ties are to a 1/4" dia. by 2.5" long PK nail with 1.25" dia. steel washer set in unblazed right face bark; and a PK nail with 2" dia. steel washer stamped BT also set in unblazed front face bark of each BT at DBH. All previous corner recovery notes from Wisconsin DNR and/or Oneida County survey records.



Scale: 1" = 30'

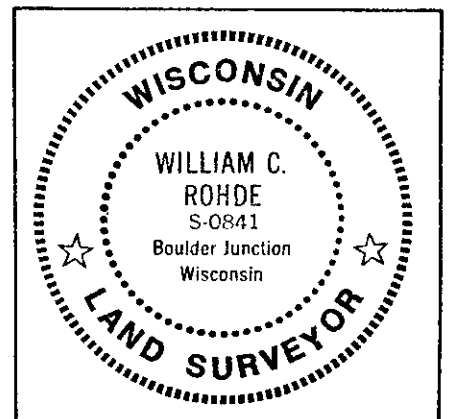

(i) I, William C. Rohde, RLS 841
(type or print name) certify that the corner location on this record was determined by me or under my direction and control and that this U.S. Public Land Survey Monument Record is correct and complete to the best of my knowledge and belief.

William C. Rohde Signature Dec. 21, 1997 Date