

CERTIFIED LAND CORNER RESTORATION



Index No. J-25

State of Wisconsin

County of Oneida } ss.

I, Daniel K. Pleoeger, do hereby certify that on the 14th day of July, 1980, I found evidence of the Section corner of Sections 7, 12, 13, 18 Township 39, North, Range 8 & 9 East, Fourth Principal Meridian, as described hereon; and that from this evidence I established a new monument and accessories as described hereon to perpetuate the original location of this corner.

Resident witnesses:

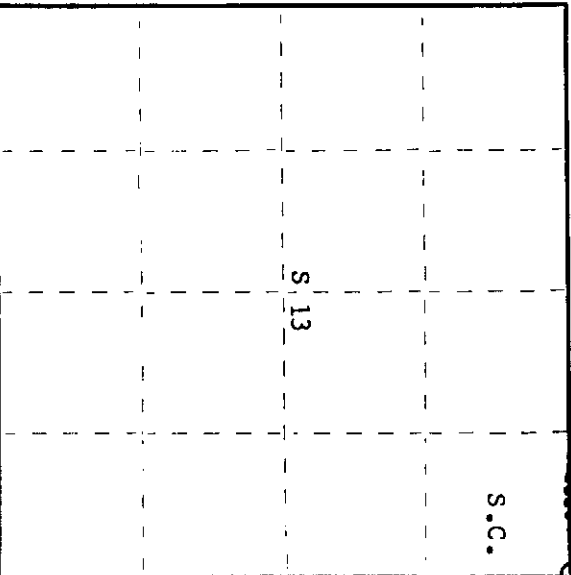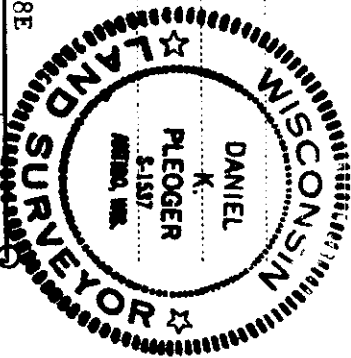

○ = Corner monument restored.

History of original corner establishment:

Corner established by Alexander Anderson, deputy surveyor, in 1863 from which Y. Pine 8" bears S88°W, 19 links - Y. Pine 8" bears N23°W, 19 links - aspen 12" bears N26°E 19 links and Y. Pine 10" bears S43°E 25 links.

Description of corner evidence found:

Recovered an old cedar post squared and scribed 7, 12, 13, 18 - also a 2" x 24" iron pipe along side post.  
 OBT's - pine stump 14" S14°E 44.70 links, some scribe marks legible.  
 r.pine 8" (12") S80°W 82.6 links, scribing grown over.  
 OBT ties fit old post.

Description of monument and accessories: I established to perpetuate the original location of this corner.

Set a 2-1/2" Oneida County federal A-1 monument with alloy cap - stamped:

Monument projects 8" above ground.  
 Marked NBT's -  
 Maple 8" S19°W 9.34 feet R T39N R  
 Maple 6" N54°E 7.35 feet 8 12 7 9  
 Maple 6" N57°W 28.55 feet E S1537-1980  
 scribed S.C. - BT

Dated at Rhineland, Wis., this 16th day of October, 1980.

Signature Daniel K. Pleoeger Title Registered Land Surveyor Registration No. 1537  
 (County Surveyor, Registered Land Surveyor, or other duly authorized official)

Office of Register of Deeds, County of Oneida, hereby certify that the within instrument was filed in this office for record on the 20th day of October, 1980 at 10:00 o'clock M.

Louis George Kuehn  
 (Register of Deeds)

By: \_\_\_\_\_ Deputy

3908120000