

CERTIFIED LAND CORNER RESTORATION

Index No. **E-20**

3909020010

State of Wisconsin

ss.


County of Oneida

Philip T. Hansen

do hereby certify that on the 22nd day of April 1975, I found evidence of the E-1/16 corner of the between Sections 2 and 11 Township 39 North, Range 9 East, Fourth Principal Meridian,

as described hereon; and that from this evidence I established a new monument and accessories as described hereon to perpetuate the original location of this corner.

Resident witnesses:

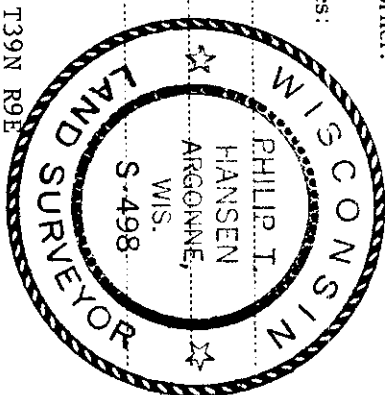

T39N R9E

History of original corner establishment:
Corner established by R. Ilg, State Surveyor, in 1971. He set a 2" iron pipe equidistant between Sec. corner 1-2-11 and 12 and the quarter corner between Sections 2 and 11. This sets in a muskeg. White pine 12" bears N87°W 0.738 chains; tamarack 5" bears S120°E 0.874 chains; and tamarack 5" bears S830°E 0.441 chains.

Description of corner evidence found:

Recovered 2" iron pipe. No brass cap.
Recovered OBT - white pine 9" S88°W 74.6 links, scribed "W" 1/8 BT.
tamarack 4" S110°E 87.7 links.

Description of monument and accessories I established to perpetuate the original location of this corner.


Replaced iron pipe with 1-1/2" iron pipe with brass cap stamped -

No additional BT's were established.

S498
T39N R9E

E-1/16 S 2
S 11

GPI-1975

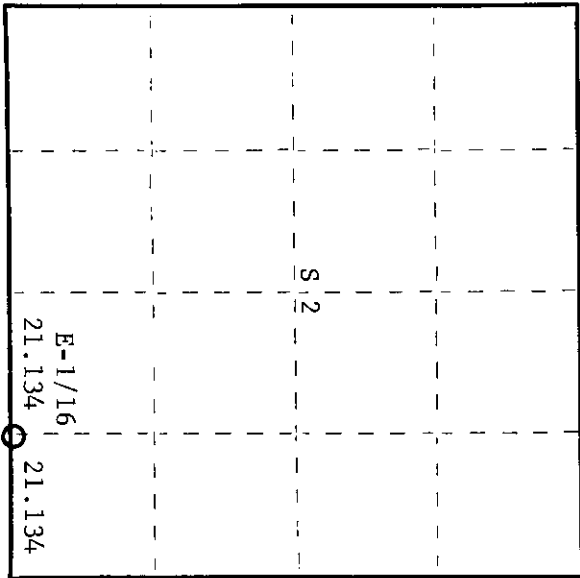

○ = Corner monument restored.

Dated at Rhineland, Wis., this 19th day of June, 1975

Signature *Philip T. Hansen* Title Registered Land Surveyor Registration No. S-498
(County Surveyor, Registered Land Surveyor, or other duly authorized official)

Office of Register of Deeds, County of Oneida
Instrument was filed in this office for record on the 1st day of October, 1975
at 3:00 o'clock P.M.

Doree George Kuehn
(Register of Deeds)

By: Deputy