

CERTIFIED LAND CORNER RESTORATION



Index No. U-24

State of Wisconsin

County of Oneida } ss.

I Phillip T. Hansen, do hereby certify that on the 24th day of August, 1978, I found evidence of the SE 1/16 corner of Section 25 Township 39, North, Range 9 East, Fourth Principal Meridian, as described hereon; and that from this evidence I established a new monument and accessories as described hereon to perpetuate the original location of this corner.

Resident witnesses:  
Jim Claflin  
Herb Wagoner

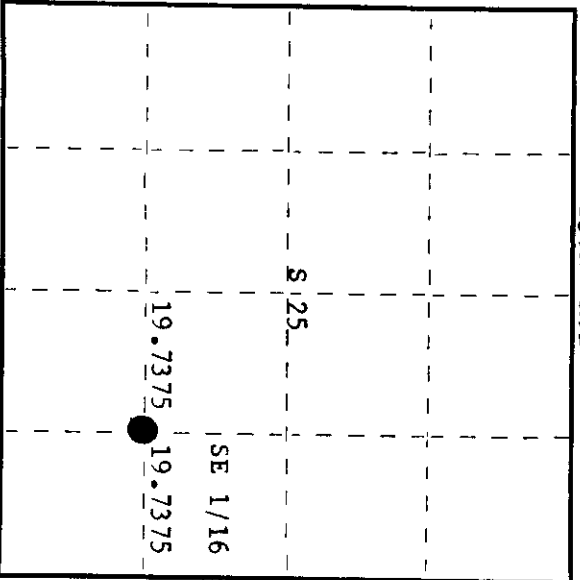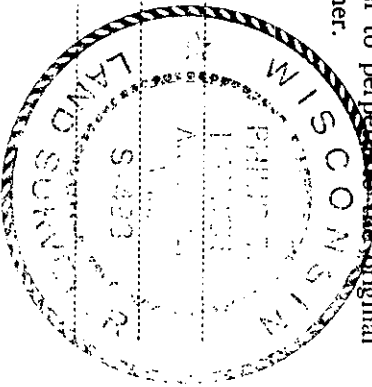

○ = Corner monument restored.

History of original corner establishment:

No records of any original survey. Corner established by Goddard and crew, Ripco surveyors, in 1960. Established SC 1/16 corner on N-S 1/4 line. Ran traverse east, bearing 88° 15' magnetic 39.475 chains to close out 1.39 chains north of S 1/16 on east line. S 1/16 corner on east line sets 4 1/2 links west of fence line. Set SE 1/16 corner at 19.73-3/4 chains intermediate. Marked NBT's - white birch 6" S24°E 16 1/2 links white birch 6" S49°W 29 links

Description of corner evidence found:

No evidence of corner monument recovered.

Recovered OBT's -  
white birch 6" (7") S24°E, 16.5 links, scribed SE 1/16 BT.  
white birch 6" (7") S49°W, 29.0 links, scribed SE 1/16 BT.  
From cross ties to BT's - recovered hole in ground where monument set.

Description of monument and accessories I established to perpetuate the original location of this corner.

Set a 1" iron pipe with 2" brass cap in hole of previous monument.  
Monument projects 16" above ground, cap stamped:  
Corner sets in a N-S fence line.

S498  
T39N R9E  
SE 1/16 S 25  
CPI-1978

Dated at Rhineland, Wis., this 6th day of November, 1978

Signature Phillip T. Hansen Title Registered Land Surveyor Registration No. S-498  
(County Surveyor, Registered Land Surveyor, or other duly authorized official)

Office of Register of Deeds, County of Oneida, I hereby certify that the within instrument was filed in this office for record on the 27th day of November, 1978 at 1:10 o'clock P. M.

Donna Venzago Kuehn  
(Register of Deeds)

By: \_\_\_\_\_ Deputy

390925 1010