U.S. PUBLIC LAND SURVEY MONUMENT RECORD

Index No. L 13

State of Wisconsin
County of Oneida } ss.

I John H. Fisher, do hereby certify that on the 1 day of May, 19 84, I found evidence of the one quarter corner of 15 and 16 Township 39, North, Range 11 East, Fourth Principal Meridian, as described hereon; and that from this evidence I established a new monument and accessories as described hereon to perpetuate the original location of this corner.

Resident witnesses.

None

History of original corner establishment: Original survey in 1859 by William E. Daugherty. Dependent Resurvey in 1941 by Hugh B. Crawford; at 39.22-1/2 chains set a concrete monument, 24 inches long, 6 inches in diameter, 20 inches in the ground, with an iron post 23 inches long, 1 inch in diameter, embedded in the center, with a brass tablet stamped: From which the following bear:

1/4
S 16 | S 15
1941

Maple	7"	N42-3/4°E	26-1/2 lks
Red Oak	7"	S59-3/4°W	59-1/2 lks

Description of corner evidence found:
B.L.M. Monument as described and in place; and the following bearing trees:

Sugar Maple	11"	N84°W	39.7 feet
Red Maple	10"	N42°E	17.3 feet
Wood sign post		NE	1.0 feet

Description of monument and accessories I established to perpetuate the original location of this corner.
Corner in good condition:
Blazed and scribed the following new bearing trees:
Set nail in:

Oak	5"	S31°E	16.5 feet
Sugar Maple	7"	N15°W	40.3 feet

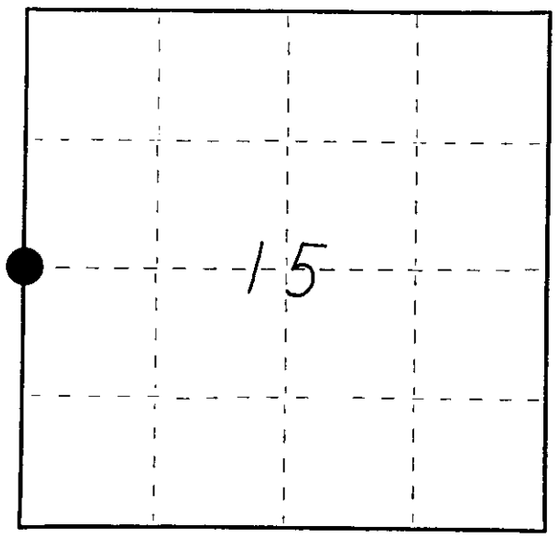

○ = Corner monument restored.

Dated at Minocqua, Wis., this 11th day of February, 1985.

Signature John H. Fisher Title Registered Land Surveyor Registration No. S-836
(County Surveyor, Registered Land Surveyor, or other duly authorized official)

Office of Register of Deeds, County of Oneida. I hereby certify that the within instrument was filed in this office for record on the 14th day of February, 19 85 at 4:15 o'clock P. M.

Doris Verage Kuehn
(Register of Deeds)

By ..... Deputy

FORM NO. 985-A
H.C. Miller Company
Stock No. 26273

391162000

(e) Describe any material discrepancy between the location of the corner as restored or reestablished and the location of that corner as previously restored or reestablished by distance and direction. Show the discrepancy on the plan view drawing under (d), above. Show the distances between the corner as previously restored or reestablished and (1) the corner as restored or reestablished, and (2) to at least 2 of the witness monuments shown on the drawing in (d), above.

See drawing below

(f) Was the corner restored through acceptance of (1) an obliterated evidence location, or, (2) a found perpetuated location?

Found perpetuated location

(g&h) Was the corner reestablished through lost corner proportionate methods? If so, show the method, including the directions and distances to other public land survey corners used as evidence or used for proportioning in determining the corner location?

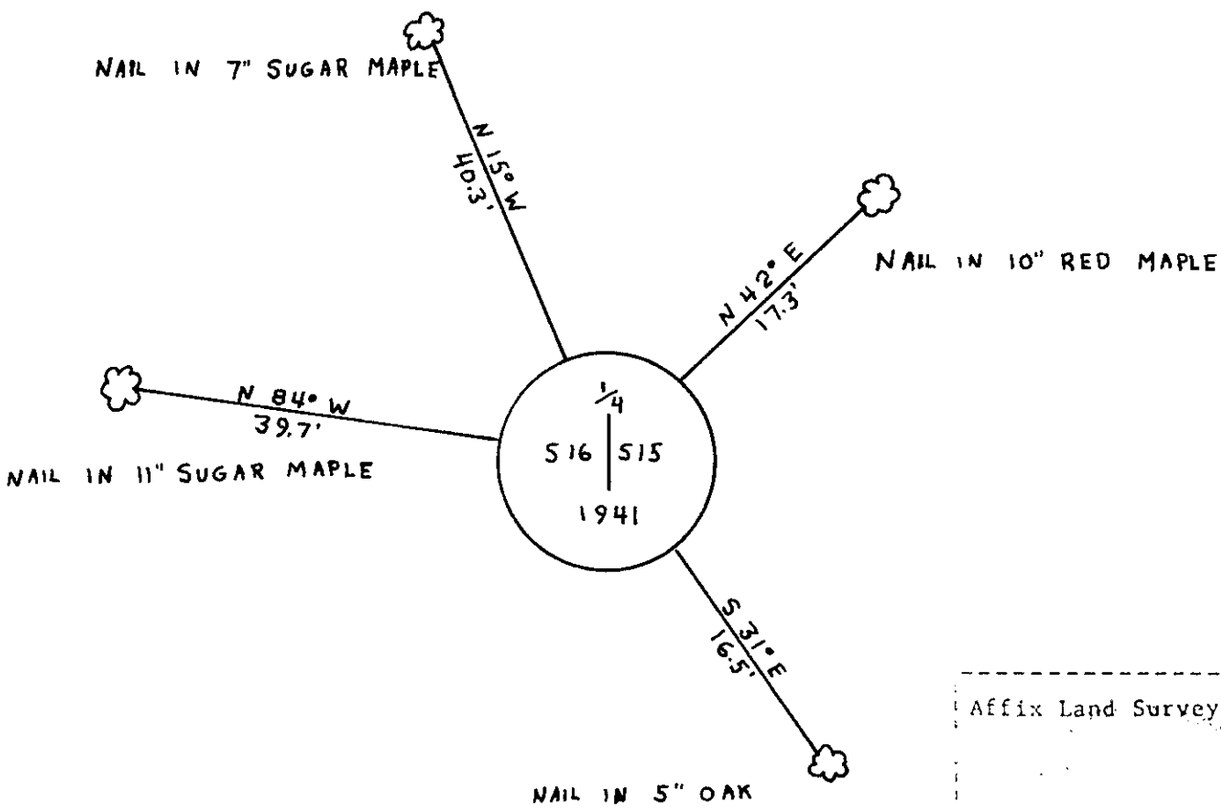

Affix Land Surveyor Seal

(i) I, John H. Fisher (type or print name) certify that the corner location shown on this record was determined by me or under my direction and control and that this U.S. Public Land Survey Monument Record is correct and complete to the best of my knowledge and belief

John H. Fisher
Signature

7/11/85
Date