U.S. PUBLIC LAND SURVEY MONUMENT RECORD

Note: This form is intended and designed to fulfill all requirements of Wisconsin Administrative Code, Chapter A-E 7.08, U.S. Public Land Survey Monument Record (3)(a)(b)(c)(d)(e)(f)(g)(h)(i). An additional sheet may be added if necessary to conform with said requirements.

(a) CORNER LOCATION
Northeast Corner of Section 6
Township 39 North
Range 5 East
Town of Minocqua

State Plane Coordinates
X
Y
Datum
County of Oneida

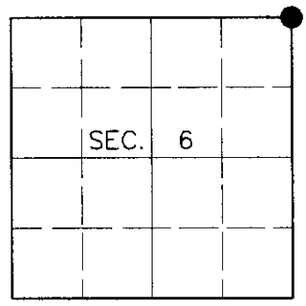

(b) HISTORY OF ORIGINAL CORNER ESTABLISHMENT

Original Surveyor: Alfred Millard

Date of Survey: Commenced Sept., 1860
Completed Sept., 1860

Original Bearing Trees:
W. Birch 4 N45°E, 8 links
W. Pine 6 N52°W, 18 links
Spruce 6 S30°E, 7 links
Hemlock 8 S37°W, 43 links

(b)(f)(g)(h) Description of monument found at this corner and if it was accepted, state all evidence (material, testimonial, occupational, plats, records, other monuments) used as a basis for accepting. If not accepted or if nothing was found, state evidence used as basis for establishing location. If reestablished through lost corner proportionate methods, indicate all monuments, distances and directions used to establish. Indicate type of monument and sign post found or set.

Oct.–Nov., 1947: Dependent Resurvey by Hugh B. Crawford, Bureau of Land Management. Crawford set a brass capped concrete monument based on remains of the original Hemlock bearing tree. He also describes an erroneous IECW concrete monument improperly set by proportion. He notes the following bearing trees: Cedar 4" N73-¾°E, 29 links; Tamarack 4" S69-¾°E, 44-½ links; Tamarack 4" S5-½°W, 19-½ links; Norway Pine 5" N29-½°W, 79 links.

June 19, 2000: I found and accepted a 5" dia. concrete monument with 2-½" dia. GLO brass tablet flush with the ground and marked as shown below. I established accessories as shown below and set a plastic sign post Northwest , 1 foot.

(c)(d)(e) Plan view of corner with ties to at least 4 witness monuments. If in disagreement with previously established corner, show the distances between the two corners and also indicate the ties to the disputed corner.

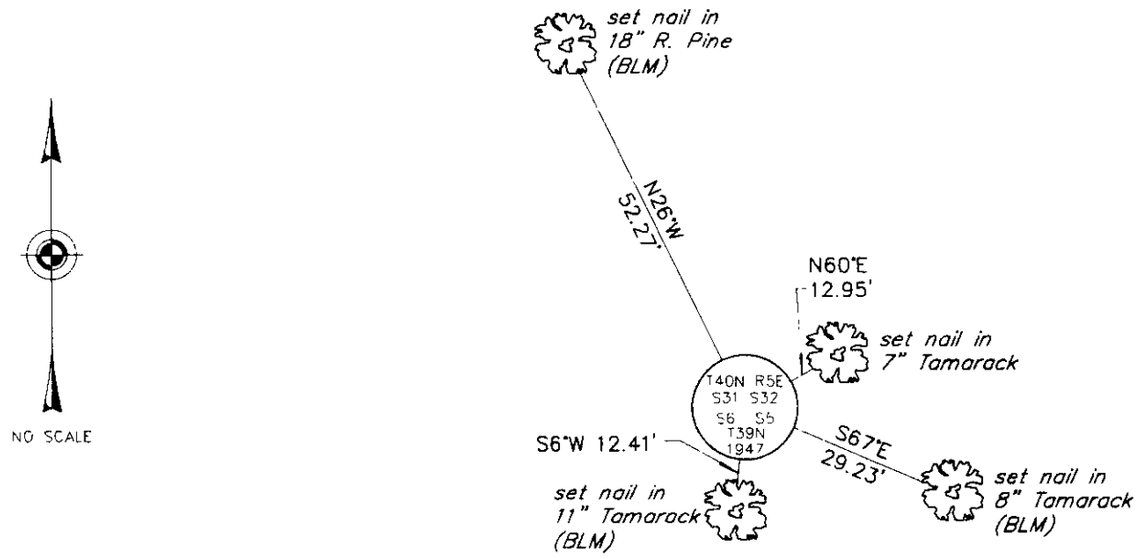

(i) I, Jeffrey W. Austin, Registered Land Surveyor S-1885, hereby certify that the corner location on this record was determined by me or under my direction and control and that this U.S. Public Land Survey Monument Record is correct and complete to the best of my knowledge and belief.

Signature

1-31-00
Date

WISCONSIN
JEFFREY W.
AUSTIN
S-1885
MINOCQUA,
WI
LAND SURVEYOR

INDEX NO. A-5

4005310000

U.S. PUBLIC LAND SURVEY MONUMENT RECORD

Note: This form is intended and designed to fulfill all requirements of Wisconsin Administrative Code, Chapter A-E 7.08 U.S. Public Land Survey Monument Record (3)(a)(b)(c)(d)(e)(f)(g)(h)(i). An additional sheet may be added if necessary to conform with said requirements.

(a) CORNER LOCATION:
Cor. of Secs. 5, 6, 31 & 32
Township 39 & 40 North
Range 5 East of the 4th P.M.
Town of Minocqua

WISCRS (Oneida County)
N: 259,836.19 USft
E: 139,972.60 USft
Datum: NAD 1983(2011)
County of Oneida

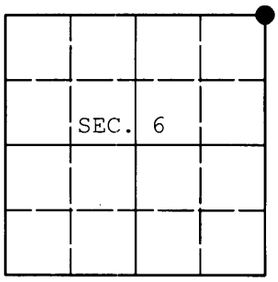

(b) HISTORY OF ORIGINAL CORNER ESTABLISHMENT

Original Surveyor:
Original Accessories:
Date of Survey: Commenced:
Completed:

(b)(f)(g)(h) Description of monument found at this corner and if it was accepted, state all evidence (material, testimonial, occupational, plats, records, other monuments) used as a basis for accepting. If not accepted or if nothing was found, state evidence used as basis for establishing location. If re-established through lost corner proportionate methods, indicate all monuments, distances and directions used to establish. Indicate type of monument and sign post found or set.

NOTE: This is a perpetuation of a previous USPLS Monument Record by Jeffrey W. Austin, RLS dated July 31, 2000 and filed in the office of the Oneida County Register of Deeds. A complete history of the corner can be found on the previous monument record. I accept the previous location as a true and faithful perpetuation or reestablishment of the original corner location and further perpetuate it as follows.

May 19, 2014: I found and accepted my previous monument, a 6" diam. concrete monument with GLO brass tablet. My accessories were found in substantial agreement with the previous record and were not remeasured as the sole purpose of this work is to report the coordinates of the corner point.

The coordinates shown were derived from a direct RTN GPS observation referenced to the WISCORS network.

(c)(d)(e) Plan view of corner with ties to at least 4 witness monuments. If in disagreement with previously established corner, show the distances between the two corners and also indicate the ties to the disputed.

REGISTER OF DEEDS OFFICE
ONEIDA COUNTY
FILED

JUL 03 2014

AT_____O'CLOCK_____M
KYLE J. FRANSON
REGISTER OF DEEDS

(i) I, Jeffrey W. Austin, Registered Land Surveyor No. S-1885, hereby certify that the corner location on this record was determined by me or under my direction and control and that this U.S. Public Land Survey Monument Record is correct and complete to the best of my knowledge and belief.

WISCONSIN
JEFFREY W. AUSTIN
S-1885
MINOCQUA, WI
LAND SURVEYOR

Signature

JUNE 28, 2014
Date

4005310000 (INDEX NO. A-5)