U.S. PUBLIC LAND SURVEY MONUMENT RECORD

Note: This form is intended and designed to fulfill all requirements of Wisconsin Administrative Code, Chapter A-E 7.08 U.S. Public Land Survey Monument Record (3)(a)(b)(c)(d)(e)(f)(g)(h)(i). An additional sheet may be added if necessary to conform with said requirements.

(a) CORNER LOCATION:

South 1/4 corner of Sec. 32

Township 40 North

Range 8 East

Town/City St. Germain

State Plane Coordinates

X Not Available

Y Not Available

Datum Base

County of Vilas/Oneida

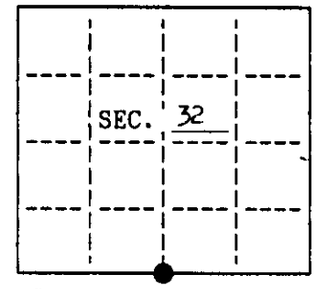

(b) HISTORY OF ORIGINAL CORNER ESTABLISHMENT

Original Surveyor: Artemus Curtis

Date of Survey: Commenced Sept. 1860

Completed Sept. 1860

Original B.T.'S
8" Spruce N 25°E, 81lks.
16" Y. Pine S 80°E 61lks.

file in section 5, T39N, R8E.

(b)(f)(g)(h) Description of monument found at this corner and if it was accepted, state all evidence (material, testimonial, occupational, plats, records, other monuments) used as a basis for accepting. If not accepted or if nothing was found, state evidence used as basis for establishing location. If reestablished through lost corner proportionate methods, indicate all monuments, distances and directions used to establish. Indicate type of monument and sign post found or set.

DNR found iron pipe from Owens Illinois map 5-16-77 and found BTs.
13" Tam. S73°E, 12.1'
12" Bal. S15°W, 5.5'

June 19, 1991: I, Michael E. Weber found 2" iron pipe and old wood post. Replaced iron pipe with 2" Vilas County Aluminum Monument and set 4x4 wood post 1' East. swamp 10' South.

See detail below for Bearing Tree information

(c)(d)(e) Plan view of corner with ties to at least 4 witness monuments. If in disagreement with previously established corner, show the distances between the two corners and also indicate the ties to the disputed.

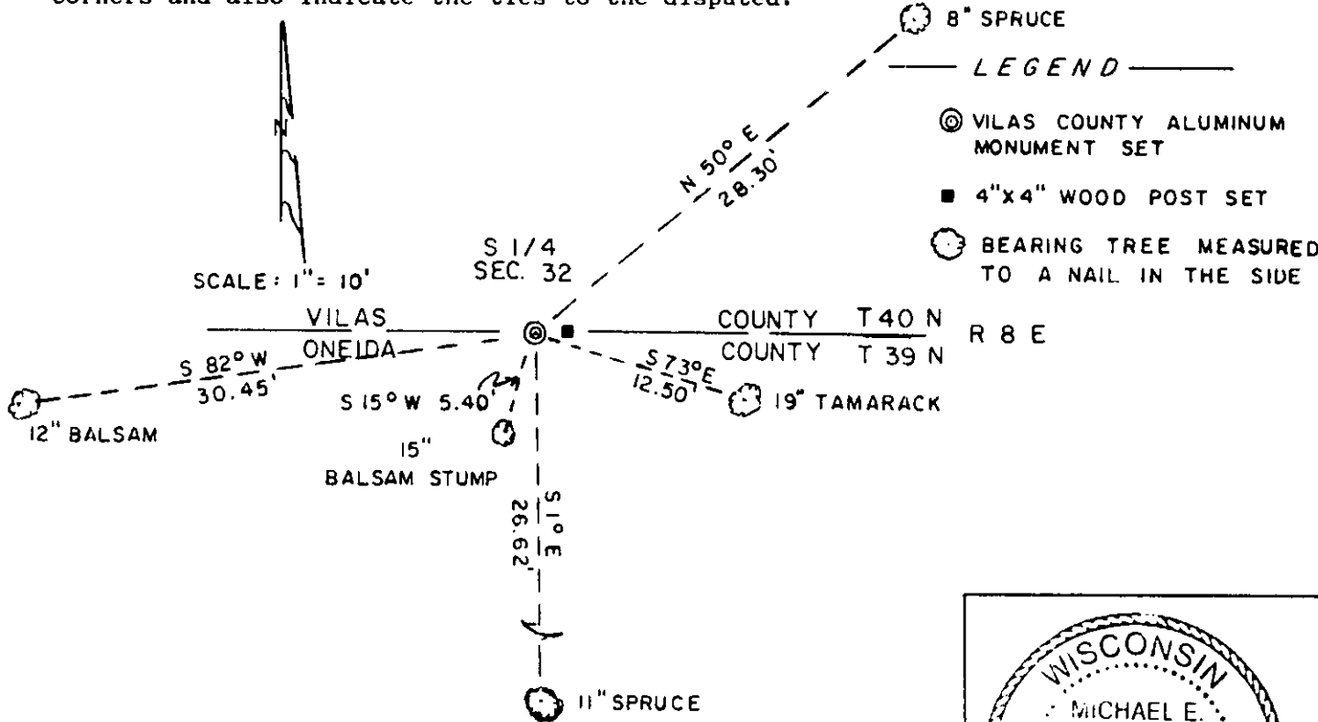

(i) I, Michael E. Weber, R.L.S. #2070 hereby certify that the corner location on this record was determined by me or under my direction and control and that this U.S. Public Land Survey Monument Record is correct and complete to the best of my knowledge and belief.

Michael E. Weber
Signature

June 20, 1991
Date

WISCONSIN MICHAEL E. WEBER S-2070 EAGLE RIVER WIS. LAND SURVEYOR

INDEX NO. A-7 Z-7

40083200 20