U.S. PUBLIC LAND SURVEY MONUMENT RECORD

Note: This form is intended and designed to fulfill all requirements of Wisconsin Administrative Code, Chapter A-E 7.08 U.S. Public Land Survey Monument Record (3)(a-l).

(a) CORNER LOCATION
Meander Cor. of Secs. 4 & 33
Township 39 & 40 North
Range 8 East of the 4th P.M.
Town of Newbold
County of Oneida

WISCRS - Oneida County
N: 259,772.75 USft
E: 242,058.80 USft
Datum: NAD 83(2011)
GNSS Method: RTN Direct
GNSS Control: WISCORS VRS

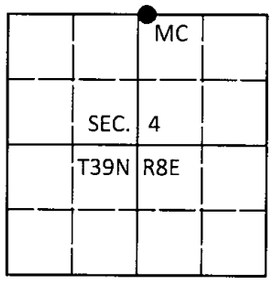

(b) HISTORY OF ORIGINAL CORNER ESTABLISHMENT

Original Surveyor: Not Set in GLO Survey Original Accessories:

Date of Survey Commenced:
Completed:

(b)(f)(g)(h) Description of monument found at this corner and if it was accepted, state all evidence (material, testimonial, occupational, plats, records, other monuments) used as a basis for accepting. If not accepted or if nothing was found, state evidence used as basis for establishing location. If re-established through lost corner proportionate methods, indicate all monuments, distances and directions used to establish. Indicate type of monument and sign post found or set.

August 31, 1979: VCS (Vilas) Map No. B-1565 by Jerome Kraemer, RLS. 2" diam. iron pipe set 60.02' West of 1" diam. iron pipe found near the water's edge.

October 4, 2016: I found and accepted the record monument, a 2-1/2" diam., 30" long iron pipe. In its place, I set a 2-1/2" diam., 30" long aluminum pipe with a 3-1/4" diam. Oneida Co. aluminum cap projecting 4" above the ground surface. I established accessories as shown below and set a white vinyl sign post bearing East, 1 ft. dist.

The coordinate value shown has been verified by at least one of the following methods: 1) comparison to a previously GPS determined published value; 2) the value is the average of two or more GPS observations at a markedly different time; 3) one or more distances were measured back to the GPS observed corner from temporary GPS observed offset locations.

(c)(d)(e) Plan view of corner with ties to at least 4 witness monuments. If in disagreement with previously established corner, show the distances between the two corners and also indicate the ties to the disputed.

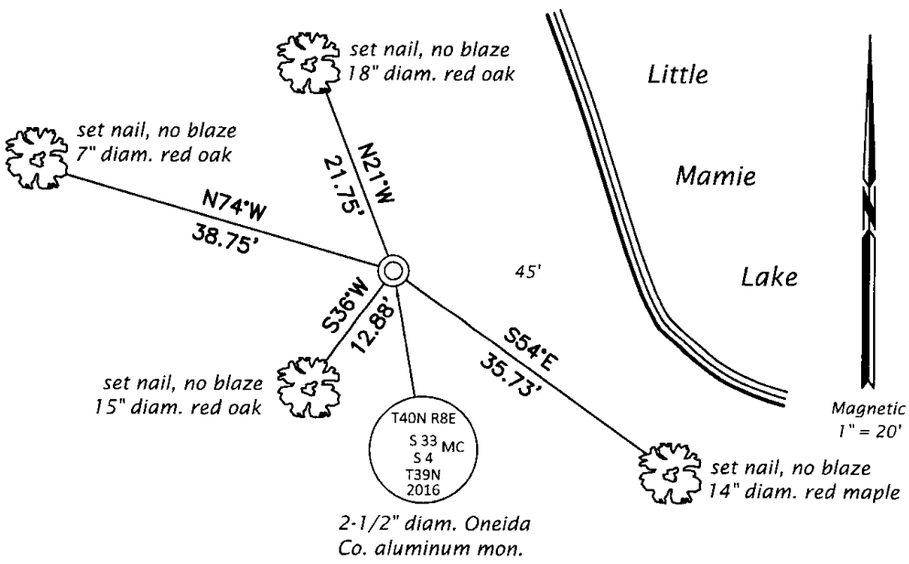

REGISTER OF DEEDS OFFICE
ONEIDA COUNTY
FILED

DEC 28 2016

AT_____O'CLOCK_____M
KYLE J. FRANSON
REGISTER OF DEEDS

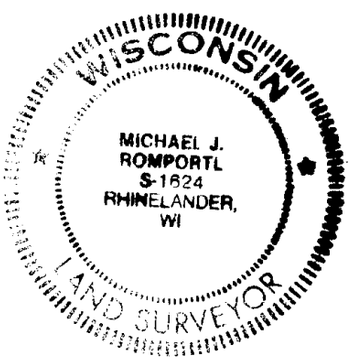

(i) I, Michael J. Romportl, Professional Land Surveyor No. S-1624, hereby certify that the corner location on this record was determined by me or under my direction and control and that this U.S. Public Land Survey Monument Record is correct and complete to the best of my knowledge and belief.

Michael J Romportl 12/23/2016
Signature Date

4008330019 (INDEX NO. A-11,12)