File in 39-8 (record From Vilas CTY)

CERTIFIED LAND CORNER RESTORATION
U.S. PUBLIC LAND SURVEY MONUMENT RECORD

Index No. A-19 / 2-19

History of original corner establishment:

Original corner was established in course of running the township line between T40N, R8E and T39N, R8E by Alex. Anderson in 1863.

Original b.t.s : W. Birch 8" N30°W, 101 lks
W. Birch 8" S39°W, 24 lks

REGISTER OF DEEDS OFFICE
ONEIDA COUNTY, WIS.
FILED
APR 10 1997
At 9:00 O'Clock a M
DORIS VERAGE KUEHN
REGISTER OF DEEDS

400835020

State of Wisconsin
County of VILAS } ss.

I Terry T. Golding, do hereby certify that on the 26 th day of May, 19 84, I found evidence of the south one-quarter corner of Section 35, Township 40, North, Range 8 East, Fourth Principal Meridian, as described hereon; and that from this evidence I established a new monument and accessories as described hereon to perpetuate the original location of this corner.

Resident witnesses:

David Dionne

Description of corner evidence found:

Found 4 witness monuments called for in Dept. of Transportation R/W project # 9081-0-21

Found no evidence of original b.t.s

Description of monument and accessories I established to perpetuate the original location of this corner.

Set a 4"x 30" Aluminum magnetic breakaway monument to replace corner position as witnessed by the reference monuments.

Used 4 existing reference monuments, see sketch on reverse side.

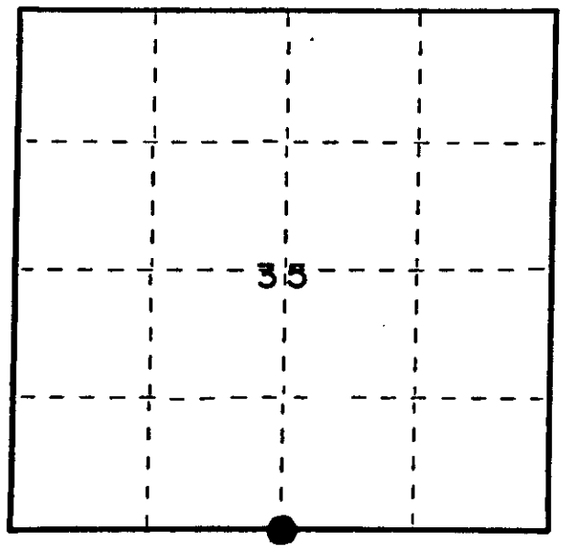

● = Corner monument restored.

Dated at Woodruff, Wis., this 26 th day of June, 19 84

Signature Terry T. Golding Title Reg. Land Surveyor Registration No. S-1468
(County Surveyor, Registered Land Surveyor, or other duly authorized official)

Office of Register of Deeds, County of ....., I hereby certify that the within instrument was filed in this office for record on the ..... day of ....., 19.....
at ..... o'clock ..... M.

.....
(Register of Deeds)

By ..... Deputy

FORM 993 Stock No. 26272

(e) Describe any material discrepancy between the location of the corner as restored or reestablished and the location of the corner as previously restored or reestablished by distance and direction. Show the discrepancy on the plan view drawing under (d), above. Show the distances between corner as previously restored or reestablished and (1) the corner as restored or reestablished, and (2) to at least 2 of the witness monuments shown on the drawing in (above.

See drawing below.

(f) Was the corner restored through acceptance of (1) an obliterated evidence location, or, (2) a found perpetuated location?

Corner was restored through acceptance of a found perpetuated location by D.O.T.

(g&h) Was the corner reestablished through lost corner proportionate methods? If so, show the method, including the directions and distances to other public land survey corners used as evidence or used for proportioning in determining the corner location?

See (f)

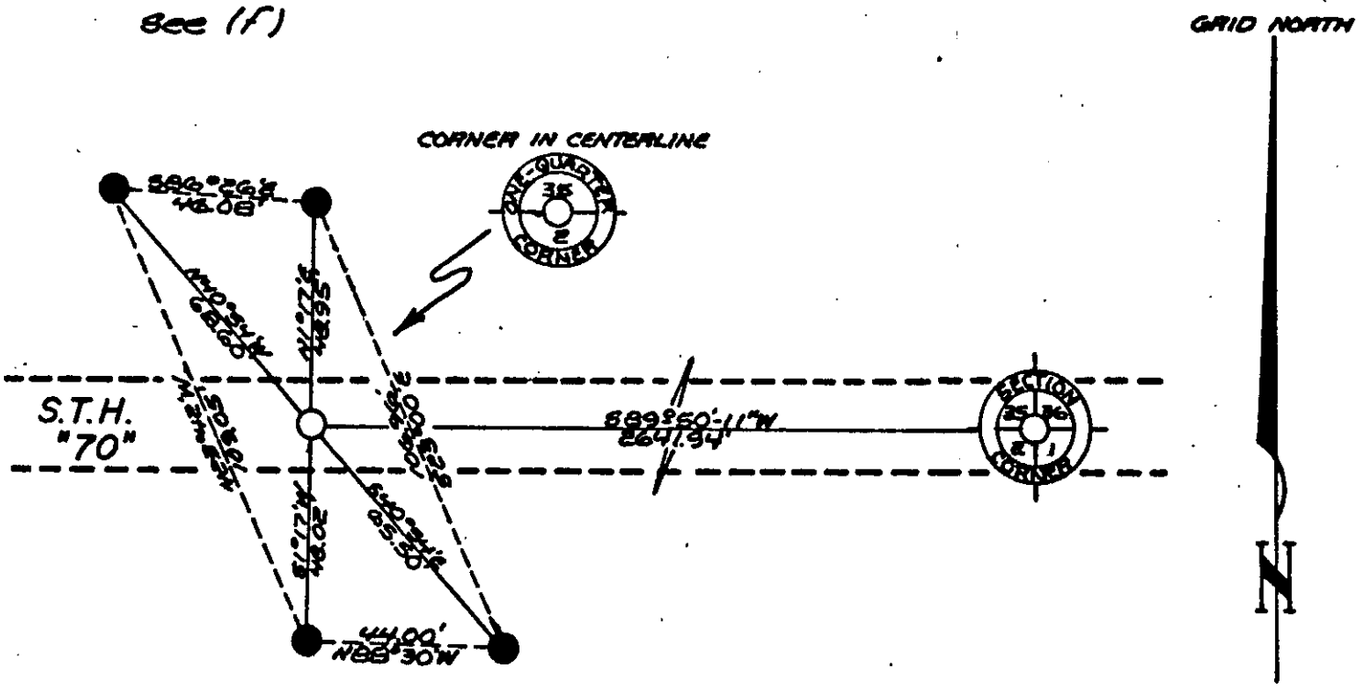

○ = 4"x 30" stamped Vilas County Aluminum Mag breakaway set.

● = stamped Aluminum Mag. breakaway found (D.O.T.)

Affix Land Surveyor Seal

WISCONSIN
TERRY T. GOLDING S-1468 WOODRUFF, WIS.
LAND SURVEYOR

(i) I, Terry T. Golding R.L.S. # S-1468
(type or print name) certify that the corner location shown on this record was determined by me or under my direction and control and that this U.S. Public Land Survey Monument Record is correct and complete to the best of my knowledge and belief.

Terry T. Golding 6/27/84
Signature Date