

CERTIFIED LAND CORNER RESTORATION



Index No. **A-17**

State of Wisconsin

County of Oneida } ss.

I, Philip T. Hansen, do hereby certify that on the 21st day of April, 1975, I found evidence of the Section Corner corner of S34, S35, S3, and S2 Township 40 and 39, North, Range 9, East, Fourth Principal Meridian, as described hereon; and that from this evidence I established a new monument and accessories as described hereon to perpetuate the original location of this corner.

Resident witnesses:

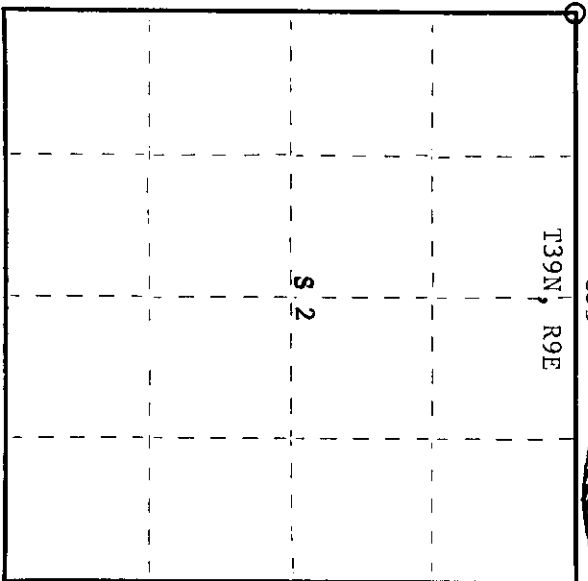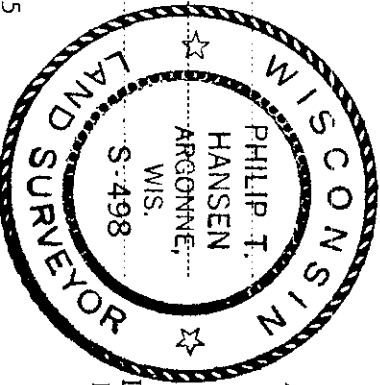

○ = Corner monument restored.

History of original corner establishment:  
Original corner established by Hiram C. Fellows, Government Deputy Surveyor, in 1859.

BT's - Red oak 6"	N57W	25 links	Red oak 10"	S16E	36 links
Red oak 10"	N64°E	30 links	Birch 10"	S50°W	33 links

Corners believed to have been restored by D. Graham, Eagle River Surveyor, who set 6" x 6" concrete posts. No record of notes. BT - pine stump S51°E 0.408 chains  
Corner restored by R.L. Ilg, State Surveyor, in 1970-72.  
Established NBT's - Red pine 18" N23°W 0.831 chains  
Red pine 24" S85°E 0.899 chains

Description of corner evidence found:

Recovered concrete monument 6" x 6", projecting 8" above ground, in good condition.  
Recovered - White pine stump, sound, 30" S52°E 40.2 links scribed T39, R9, S2 BT  
Red pine 24" S85°E 89.8 links scribed 'W' S2 BT  
Red pine 18" N24°W 82.5 links scribed 'W' SW S34 BT  
Jack pine 8" N1°E 22.8 links scribed T40N, R9E, S35 BT

Also a number of beaver blazes on various trees.  
Description of monument and accessories I established to perpetuate the original location of this corner.  
No additional accessories established.

4009340000

Dated at Rhineland, Wis., this 15th day of May, 1975.

Signature Philip T. Hansen Title Registered Land Surveyor Registration No. S-498  
County Surveyor, Registered Land Surveyor, or other duly authorized official)  
Office of Register of Deeds, County of Oneida  
Instrument was filed in this office for record on the 1st day of October, 1975  
at 3:20 o'clock M.

Dorcas George Keelin  
(Register of Deeds)

By: \_\_\_\_\_ Deputy