C1773

MAP # C1773
DATE FILED MAR 16 2001
BY
DESCRIPTION FILED
ONEIDA CO. SURVEYOR'S OFFICE

LEGEND

These standard symbols will be found in the drawing.

- POWER POLE
- ELECTRICAL TRANSFORMER
- TELEPHONE PEDESTAL
- LIGHT POLE
- SANITARY MANHOLE
- STORM MANHOLE
- CATCH BASIN
- SOCCER GOAL
- WATER VALVE
- HYDRANT
- GOAL POSTS
- GUY
- BASKETBALL HOOP
- WOODEN POLE
- 2" IRON PIPE FOUND
- PROPERTY CORNER
- FENCE
- SANITARY
- STORM
- POWER OVERHEAD
- BURIED ELECTRIC
- BURIED TELEPHONE
- EDGE OF BITUMINOUS
- FLAG POLE
- TREE
- PINE TREE
- BUSH
- MANHOLE
- TELEPHONE POLE
- CATCHBASIN
- IRON PIPE FOUND
- BURIED TV CABLE
- 6" WATER MAIN
- CONTOUR LINE
- GAS METER
- SCORE BOARD
- TELEVISION PEDESTAL
- SHOP VENT

SCALE 1"=120'

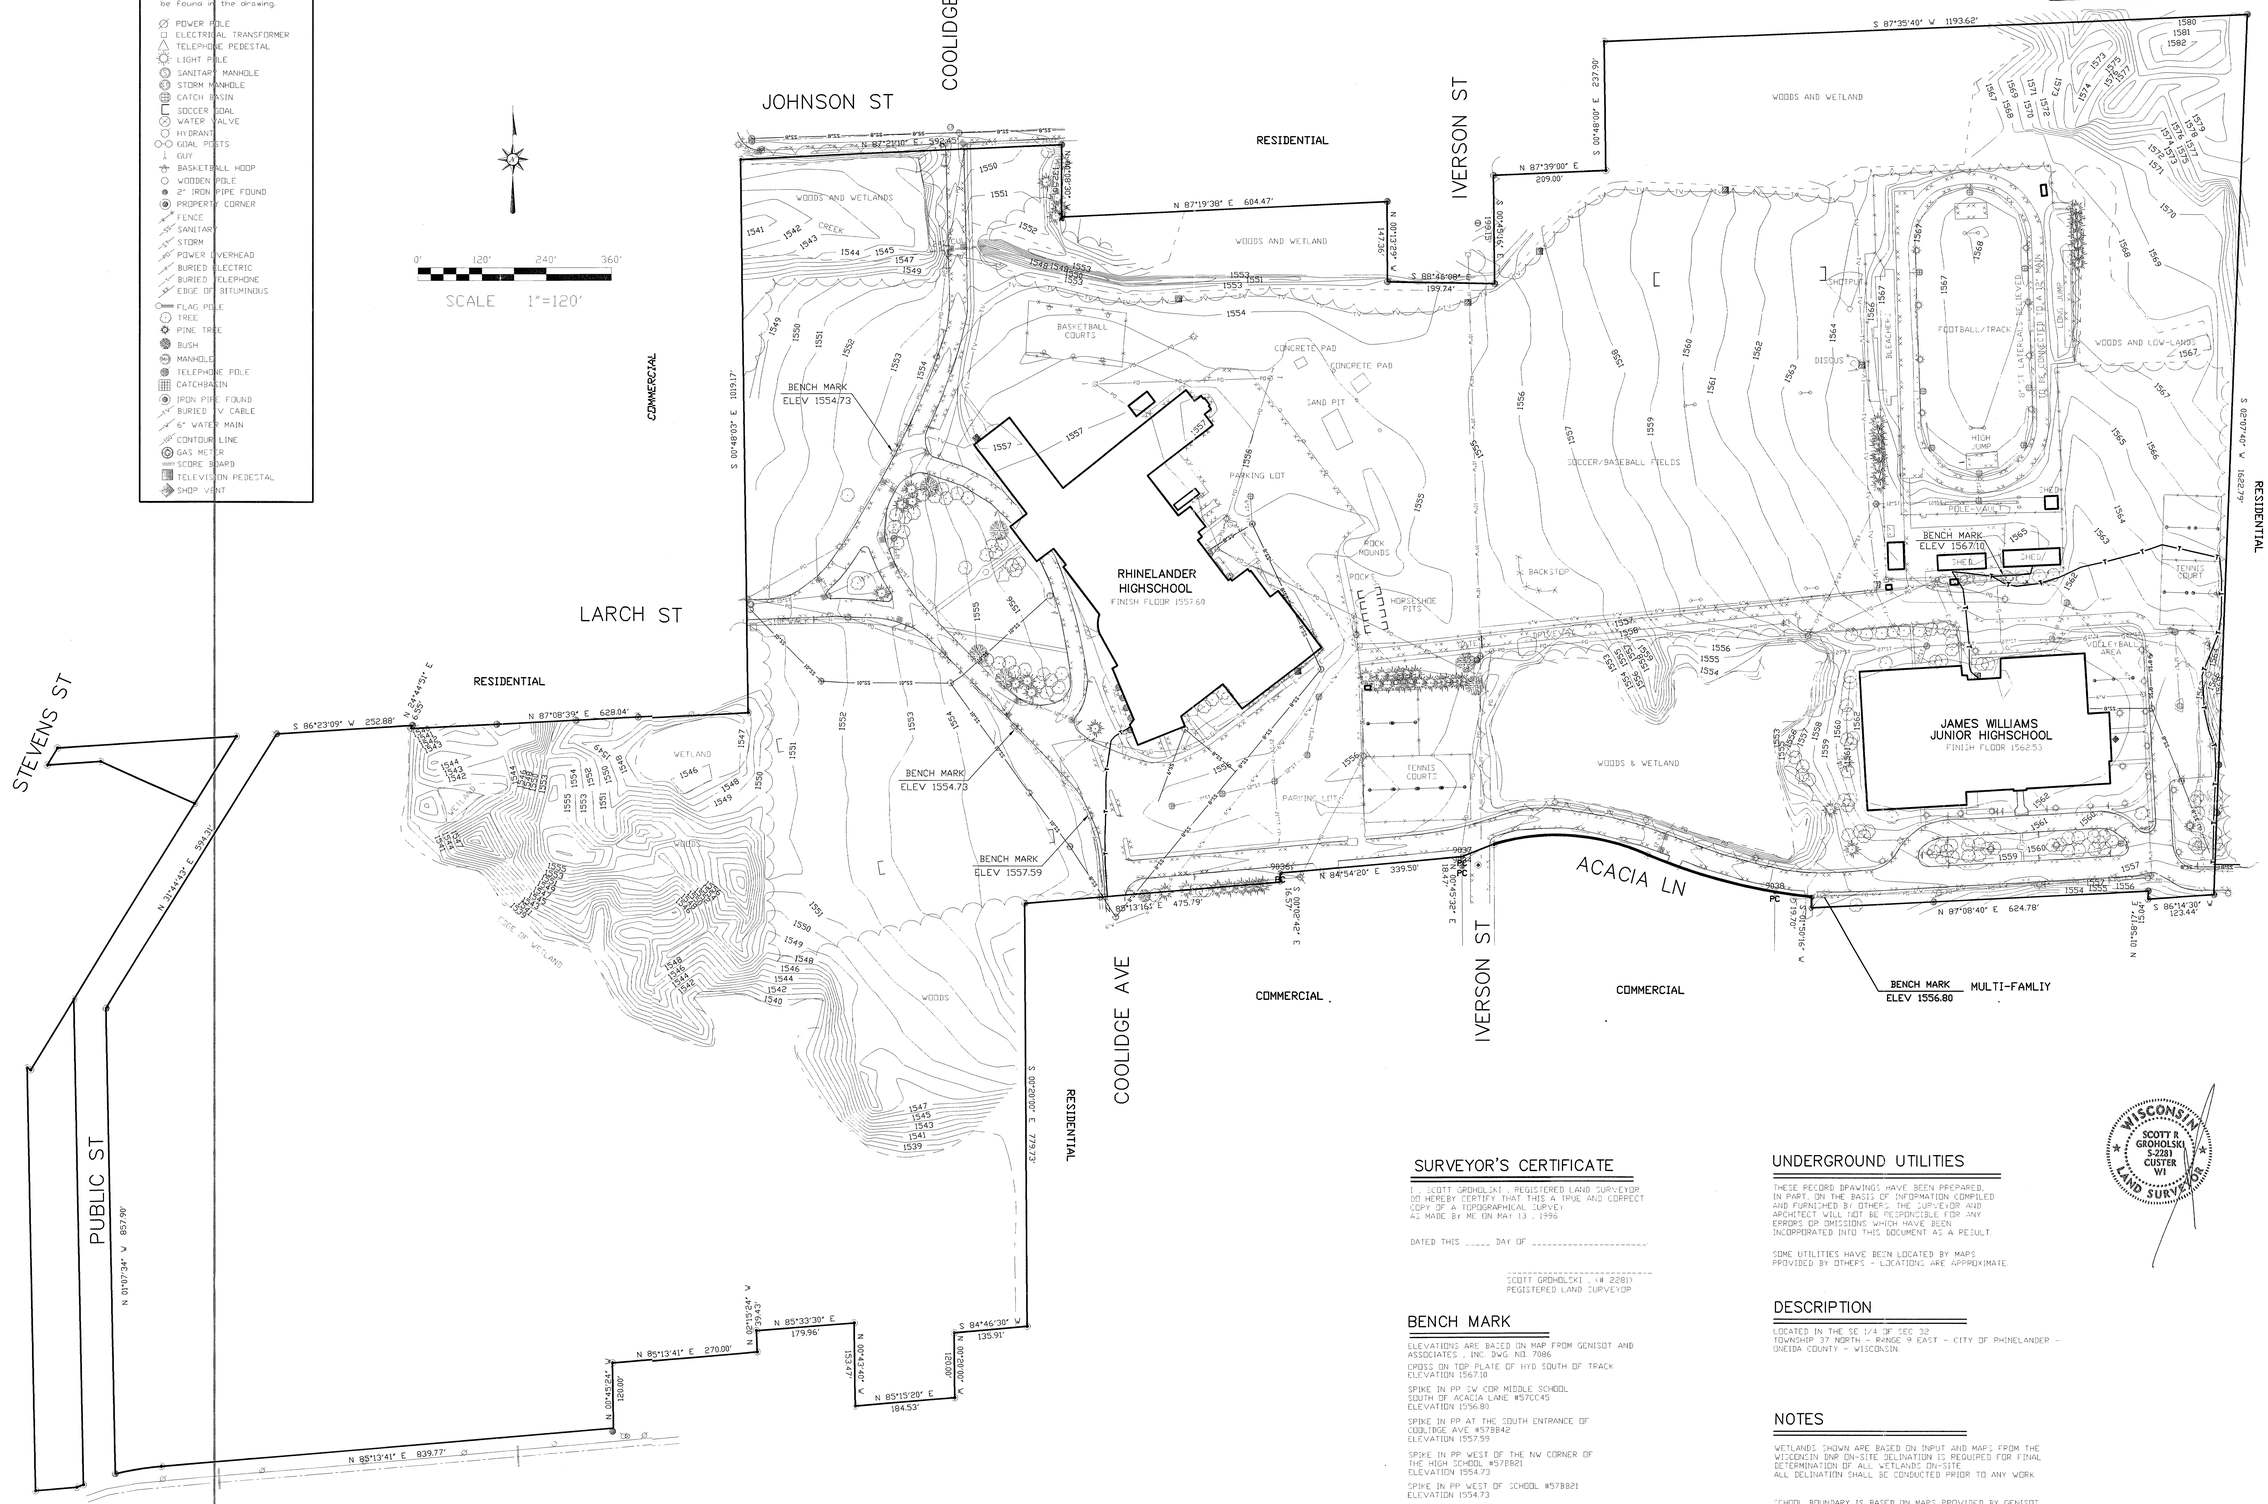

SURVEYOR'S CERTIFICATE

I, SCOTT GROHOLSKI, REGISTERED LAND SURVEYOR DO HEREBY CERTIFY THAT THIS A TRUE AND CORRECT COPY OF A TOPOGRAPHICAL SURVEY AS MADE BY ME ON MAY 13, 1996

DATED THIS _____ DAY OF _____

SCOTT GROHOLSKI, (# 2281)
REGISTERED LAND SURVEYOR

BENCH MARK

ELEVATIONS ARE BASED ON MAP FROM GENISOT AND ASSOCIATES, INC. DWG. NO. 7086

CROSS ON TOP PLATE OF HYD SOUTH OF TRACK
ELEVATION 1567.10

SPIKE IN PP SW COR MIDDLE SCHOOL
SOUTH OF ACACIA LANE #57CC45
ELEVATION 1556.80

SPIKE IN PP AT THE SOUTH ENTRANCE OF
COOLIDGE AVE #57B842
ELEVATION 1557.59

SPIKE IN PP WEST OF THE NW CORNER OF
THE HIGH SCHOOL #57B821
ELEVATION 1554.73

SPIKE IN PP WEST OF SCHOOL #57BB21
ELEVATION 1554.73

UNDERGROUND UTILITIES

THESE RECORD DRAWINGS HAVE BEEN PREPARED, IN PART, ON THE BASIS OF INFORMATION COMPILED AND FURNISHED BY OTHERS. THE SURVEYOR AND ARCHITECT WILL NOT BE RESPONSIBLE FOR ANY ERRORS OR OMISSIONS WHICH HAVE BEEN INCORPORATED INTO THIS DOCUMENT AS A RESULT.

SOME UTILITIES HAVE BEEN LOCATED BY MAPS PROVIDED BY OTHERS - LOCATIONS ARE APPROXIMATE.

DESCRIPTION

LOCATED IN THE SE 1/4 OF SEC 32
TOWNSHIP 37 NORTH - RANGE 9 EAST - CITY OF RHINELANDER - ONEIDA COUNTY - WISCONSIN.

NOTES

WETLANDS SHOWN ARE BASED ON INPUT AND MAPS FROM THE WISCONSIN DNR ON-SITE DELINATION IS REQUIRED FOR FINAL DETERMINATION OF ALL WETLANDS ON-SITE. ALL DELINATION SHALL BE CONDUCTED PRIOR TO ANY WORK.

SCHOOL BOUNDARY IS BASED ON MAPS PROVIDED BY GENISOT AND ASSOCIATES

WISCONSIN
SCOTT R GROHOLSKI
S-2281
CUSTER
WI
LAND SURVEYOR

MAP # C1773
DATE FILED MAR 16 2001
BY
DESCRIPTION FILED
ONEIDA CO. SURVEYOR'S OFFICE

©LOT KO BUTLER CORPORATION, INC. ALSON WE RIGHTS RESERVED COPYRIGHT IN AND TO THESE PLANS, SPECIFICATIONS AND DESIGNS INCORPORATED HEREIN ARE THE PROPERTY OF LOT KO BUTLER CORPORATION, INC. AND SHALL NOT BE USED IN WHOLE OR IN PART WITHOUT THE WRITTEN CONSENT OF LOT KO BUTLER CORPORATION, INC.
©1997 LOT KO BUTLER CORPORATION, INC.

REVISIONS

DATE	5/09/96
DRAWN	DAN PEPLINSKI
CHECKED	RICK REITLER
DOCUMENT NO.	95.022

LANDSCAPE ARCHITECTURE
ENGINEERING
LAND SURVEYING
SITE CONSTRUCTION MANAGEMENT
SITE MAINTENANCE
5917 BUSINESS PARK DRIVE :: STEVENS POINT, WI 54481
TELEPHONE 715 - 341 - 2855 FAX 715 - 341 - CADD EMAIL rr@rrhr.com

TOPOGRAPHIC MAP

CITY OF RHINELANDER
RHINELANDER HIGH SCHOOL

TOPO