


U.S. PUBLIC LAND SURVEY MONUMENT RECORD

Note: This form is intended and designed to fulfill all requirements of Wisconsin Administrative Code, Chapter A-E 7.08 U.S. Public Land Survey Monument Record (3) (a) (b) (c) (d) (e) (f) (g) (h) (i). An additional sheet may be added if necessary to conform with said requirements.

(a) Corner location: Township 35 North
 Range 9 East/West

Town/City/Village Enterprise

County Oneida

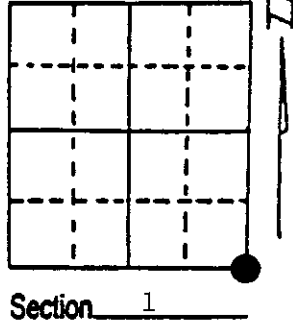

(b) (f) (g) (h) Description of monument found at this corner and if it was accepted, state all evidence (material, testimonial, occupational, plats, records, other monuments) used as a basis for accepting. If not accepted or if nothing was found, state evidence used as basis for establishing location. If reestablished through lost corner proportionate methods, indicate all monuments, distances and directions used to establish. Indicate type of monument found or set and sign post.

1859 - Hiram Fellows established this corner and set wood post and four BTs:
 9" Spruce, N20°E, 12 Links 8" Tamarack, S55°E, 18 Links
 9" Cedar, S70°W, 12 Links 7" Spruce, N35°W, 18 Links

1932 or 33-H.C. Hall restored corner from original BT and set a 6" x 6" concrete monument.


8/1/1935 - Maine found Hall's monument and did nothing.

10/27/89 - Milo E. Stefan found Hall monument and several new BTs.

(c) (d) (e) Plan view of corner with ties to at least 4 witness monuments. If in disagreement with previously established corner, show the distances between the two corners and also indicate the ties to the disputed corner.

- 1) 6" x 6" Concrete monument/brass cap
- 2) 8" Tamarack, N71°E, 6.71' (overgrown)
- 3) 4" Cedar, N19°E, 27.72'
- 4) 10" Cedar, S30°W, 33.18'
- 5) 8" Cedar, S71°W, 13.44'
- 6) Plastic sign post next to monument

Distances to nail in side of BTs
 BT stumps scribed "BT"

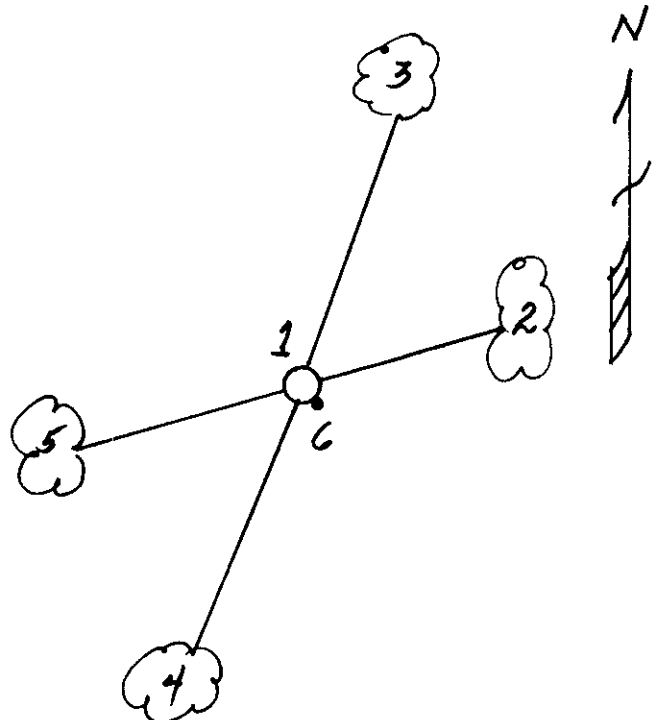

(i) I, Milo E. Stefan
 (type or print name) certify that the corner location on this record was determined by me or under my direction and control and that this U.S. Public Land Survey Monument Record is correct and complete to the best of my knowledge and belief.

Milo E. Stefan 11/5/89
 Signature Date



Index No. E-25