U.S. PUBLIC LAND SURVEY MONUMENT RECORD

Note: This form is intended and designed to fulfill all requirements of Wisconsin Administrative Code, Chapter A-E 7.08 U.S. Public Land Survey Monument Record (3) (a) (b) (c) (d) (e) (f) (g) (h) (i). An additional sheet may be added if necessary to conform with said requirements.

(a) Corner location: Township 35 North

Range 9 East/West

Town/City/Village Enterprise

County Oneida

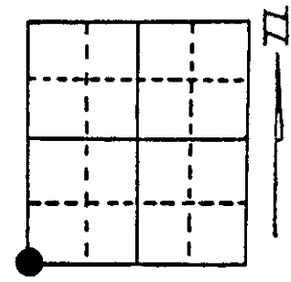

Section 2

(b) (f) (g) (h) Description of monument found at this corner and if it was accepted, state all evidence (material, testimonial, occupational, plats, records, other monuments) used as a basis for accepting. If not accepted or if nothing was found, state evidence used as basis for establishing location. If reestablished through lost corner proportionate methods, indicate all monuments, distances and directions used to establish. Indicate type of monument found or set and sign post.

1864 - James Nowlin established this corner and set a wood post with two BTs and two Witness Trees:
8" Tamarack, S40°W, 15 Links — 7" Tamarack, N42°E, 30 Links
5" Tamarack — 6" Tamarack

9/9/1936 - Maine found both original BTs with marks plain. He set a 2 1/4" x 60" iron pipe with brass cap and two new BTs:
4" Tamarack, N54°W, 65 1/2 Links — 4" Spruce, S68°E, 21 1/2 Links

11/15/1989 - Milo E. Stefan found Maine's monument in good condition and made four new BTs and set a plastic sign post.

(c) (d) (e) Plan view of corner with ties to at least 4 witness monuments. If in disagreement with previously established corner, show the distances between the two corners and also indicate the ties to the disputed corner.

1) 2 1/4" x 60" iron pipe/brass cap
2) 3" Tamarack, N15°E, 26.50'
3) 4" Tamarack, S43°E, 44.77'
4) 6" Black Spruce, S12°E, 20.89'
5) 3" Tamarack, S38°W, 27.79'
6) Plastic sign post along side monument

Distances from nail in side of BTs

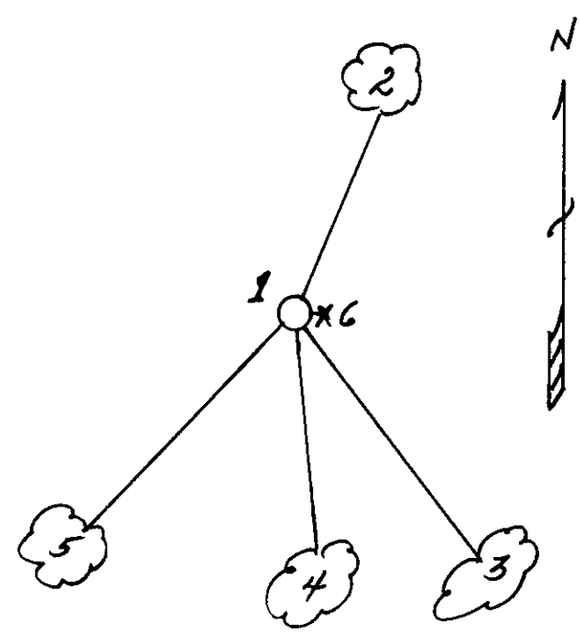

(i) I, Milo E. Stefan (type or print name) certify that the corner location on this record was determined by me or under my direction and control and that this U.S. Public Land Survey Monument Record is correct and complete to the best of my knowledge and belief.

Milo E. Stefan — 11/17/89

Signature — Date

WISCONSIN MILO E. STEFAN S-1558 RHINELANDER, WIS. LAND SURVEYOR

Index No. E-17