CERTIFIED LAND CORNER RESTORATION

Index No. H-1

State of Wisconsin
County of Oneida } ss.

I Philip T. Hansen, do hereby certify that on the 21st day of March, 1978, I found evidence of the S 1/16 corner of Section 7 and 12 Township 35, North, Range 9 & 10 East, Fourth Principal Meridian, as described hereon; and that from this evidence I established a new monument and accessories as described hereon to perpetuate the original location of this corner.

Resident witnesses:

Glen Barker

Jim Claflin

Herb Wagoner

WISCONSIN PHILIP T. HANSEN ARCHIVES S-498 LAND SURVEYOR

T35N R10E

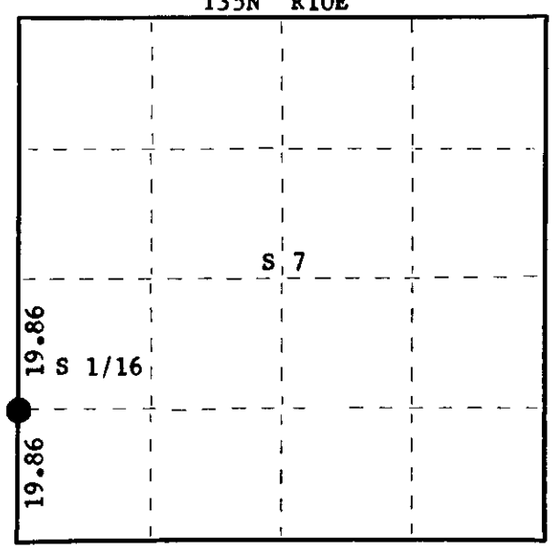

○ = Corner monument restored.

History of original corner establishment:

Corner established by V.M. Maine, set iron pipe and marked NBT's - cedar 10" N15°E, 16½ links; cedar 5" N22°W, 23½ links.
Corner recovered by H.C. Lawrence, Registered Land Surveyor, in 1946. Set cedar post beside iron pipe. No record of any NBT's.

Description of corner evidence found:

Recovered 2½" iron pipe with screw in brass cap, stamped:
Monument recovered in excellent condition, projects 24" above ground.
Recovered OBT's - cedar 10" N15°E, 16.5 links, now a stump.
cedar 5" (8") N22°W, 23½ links, scribing partly visible.
cedar 14" N22°E, 62.1 links, scribed BT.

R 9 S12 T35N 1 + 8 S7 R 10

Description of monument and accessories I established to perpetuate the original location of this corner.

Monument left in place as recovered.
No additional accessories established.

Dated at Rhinelander, Wis., this 5th day of April, 1978

Signature Philip T. Hansen Title Registered Land Surveyor Registration No. S-498
(County Surveyor, Registered Land Surveyor, or other duly authorized official)

Office of Register of Deeds, County of Oneida, I hereby certify that the within instrument was filed in this office for record on the 17th day of April, 1978 at 1:50 o'clock P M.

Doris Verage Kuehn
(Register of Deeds)

By ..... Deputy

FORM 985 H. C. MILLER CO., MILWAUKEE

3509/2/000