

# U.S. PUBLIC LAND SURVEY MONUMENT RECORD


**Note:** This form is intended and designed to fulfill all requirements of Wisconsin Administrative Code, Chapter A-E 7.08 U.S. Public Land Survey Monument Record (3) (a) (b) (c) (d) (e) (f) (g) (h) (i). An additional sheet may be added if necessary to conform with said requirements.

(a) Corner location: Township 35 North

Range 9 East/West

Town/City/Village Enterprise

County Oneida

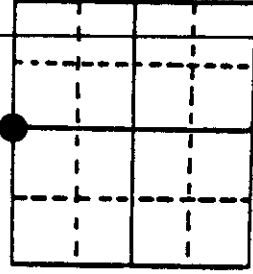

Section 20

(b) (f) (g) (h) Description of monument found at this corner and if it was accepted, state all evidence (material, testimonial, occupational, plats, records, other monuments) used as a basis for accepting. If not accepted or if nothing was found, state evidence used as basis for establishing location. If reestablished through lost corner proportionate methods, indicate all monuments, distances and directions used to establish. Indicate type of monument found or set and sign post.

1864 - James Nowlin established this corner and set wood post with two BTs:  
 10" Hemlock, N81°E, 9 Links                      9" Hemlock, S81°W, 8 Links


7/20/1935 - Maine found old stake and stump of original BT; Hemlock, S81°W, 8 links.  
 He set a 2 1/2" x 60" iron pipe/brass cap and made two references:  
 48" Gray Boulder, S23°E, 14 Links; 48" Gray Boulder, N46°W, 6 Links  
 (bearing in error, should read N46°E)

11/28/1989 - Milo E. Stefan found Maine's monument and boulders in place. We made two new references and set plastic sign post.

(c) (d) (e) Plan view of corner with ties to at least 4 witness monuments. If in disagreement with previously established corner, show the distances between the two corners and also indicate the ties to the disputed corner.

- 1) 2 1/2" x 60" iron pipe/screw on brass cap
- 2) 48" x 42" x 12" gray boulder, N46°E, 3.5'
- 3) 48" x 60" x 12" gray boulder, S23°E, 7.6'
- 4) 3" Sugar Maple, S25°W, 50.67'
- 5) 6" Red Maple, N33°W, 4.70'
- 6) Plastic sign post, east, 1.0'

Distances to edge of boulders  
 Distances to nail in side of BTs  
 Stump blazes scribed "BT"

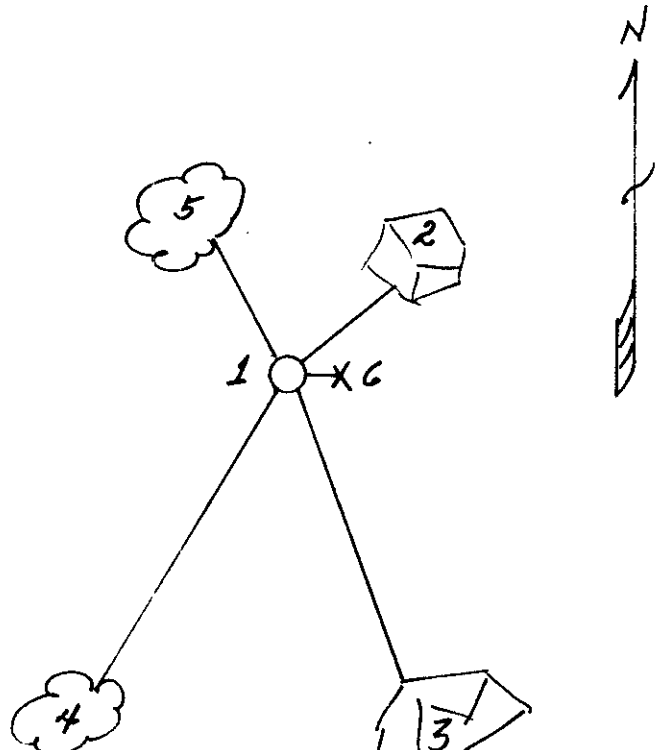

(i) I, Milo E. Stefan  
 (type or print name) certify that the corner location on this record was determined by me or under my direction and control and that this U.S. Public Land Survey Monument Record is correct and complete to the best of my knowledge and belief.

Milo E. Stefan  
 Signature

11/29/89  
 Date



Index No. P-5

3501 18 2010