U.S. PUBLIC LAND SURVEY MONUMENT RECORD

Note: This form is intended and designed to fulfill all requirements of Wisconsin Administrative Code, Chapter A-E 7.08 U.S. Public Land Survey Monument Record (3) (a) (b) (c) (d) (e) (f) (g) (h) (i). An additional sheet may be added if necessary to conform with said requirements.

(a) Corner location: Township 35 North

Range 9 East/~~West~~

Town/~~City/Village~~ Enterprise

County Oneida

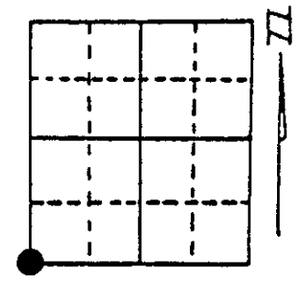

Section 27

(b) (f) (g) (h) Description of monument found at this corner and if it was accepted, state all evidence (material, testimonial, occupational, plats, records, other monuments) used as a basis for accepting. If not accepted or if nothing was found, state evidence used as basis for establishing location. If reestablished through lost corner proportionate methods, indicate all monuments, distances and directions used to establish. Indicate type of monument found or set and sign post.

1864 - James Nowlin established this corner and set a wood post with two BTs:
14" Pine, S37°W, 75 Links 8" Pine, S27°E, 60 Links

3/9/1936 - Maine found stumps of original BTs and restored corner by placement of a 2 1/4" x 60" iron pipe/brass cap monument with three BTs:
12" N. Pine, S25°W, 89 Links 12" Hemlock, S9°E, 62 1/4 Links
8" W. Pine, S77°E, 1.17 1/2 Chains

12/13/1989 - Milo E. Stefan found Maine's monument and all his BTs in good condition. We made one new BT and set a plastic sign post.

(c) (d) (e) Plan view of corner with ties to at least 4 witness monuments. If in disagreement with previously established corner, show the distances between the two corners and also indicate the ties to the disputed corner.

1) 2 1/4" x 60" iron pipe/brass cap
2) 12" White Pine, S77°E, 77.14' (Maines)
3) 14" Hemlock, S9°E, 43.74' (Maines)
4) 22" Red Pine, S25°W, 58.98' (Maines)
5) 8" Tamarack, N80°W, 56.74'
6) Plastic sign post, northeast, 1.0'

Distances to nail in side of BTs.
Stump blazes scribed "BT".

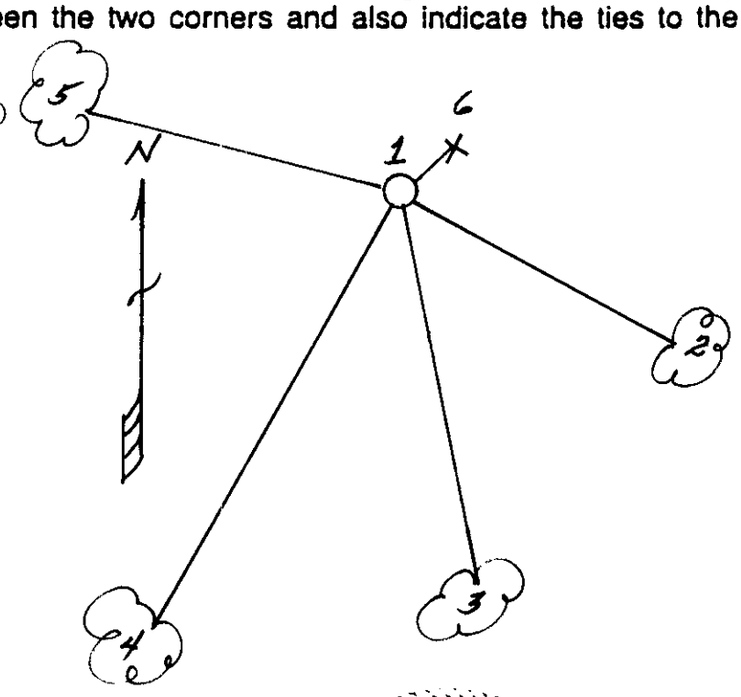

(i) I, Milo E. Stefan (type or print name) certify that the corner location on this record was determined by me or under my direction and control and that this U.S. Public Land Survey Monument Record is correct and complete to the best of my knowledge and belief.

Milo E. Stefan 12/16/89

Signature Date

WISCONSIN MILO E. STEFAN S-1055 RHINELANDER, WIS. LAND SURVEYOR

Stamp

Index No. V-13

3509280000