U.S. PUBLIC LAND SURVEY MONUMENT RECORD

Note: This form is intended and designed to fulfill all requirements of Wisconsin Administrative Code, Chapter A-E 7.08 U.S. Public Land Survey Monument Record (3) (a) (b) (c) (d) (e) (f) (g) (h) (i). An additional sheet may be added if necessary to conform with said requirements.

(a) Corner location: Township 35 North

Range 9 East/~~West~~

Town/~~City/Village~~ Enterprise

County Oneida

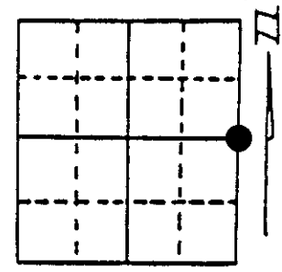

Section 36

(b) (f) (g) (h) Description of monument found at this corner and if it was accepted, state all evidence (material, testimonial, occupational, plats, records, other monuments) used as a basis for accepting. If not accepted or if nothing was found, state evidence used as basis for establishing location. If reestablished through lost corner proportionate methods, indicate all monuments, distances and directions used to establish. Indicate type of monument found or set and sign post.

1859 - Hiram Fellows established this corner and set a wood post with two BTs:
7" Tamarack, S70°E, 9 Links 10" Tamarack, S80°W, 10 Links

4/9/1936 - Maine found 1/4 stake and remains of both original BTs: SE, stub and SW, tree down. He restored corner by placement of a 2 1/4" x 60" iron pipe/brass cap and two new BTs:
4" Tamarack, N23°W, 33 Links 5" Tamarack, N74 1/2°W, 62 Links

12/28/1989 - Milo E. Stefan found Maine's monument in fair condition. Brass cap pounded on so as to make it illegible. 5" Tamarack stub, N75°W, 62 links - a stub with scribing present and 4" Tamarack, N23°W, 33 links - down. We made new BTs and set plastic sign post.

(c) (d) (e) Plan view of corner with ties to at least 4 witness monuments. If in disagreement with previously established corner, show the distances between the two corners and also indicate the ties to the disputed corner.

1) 2 1/4" x 60" iron pipe/brass cap
2) 6" Tamarack, N42°E, 23.33'
3) 6" Tamarack, N74°E, 37.44'
4) 6" Tamarack, N73°W, 44.49'
5) 4" Tamarack, N26°W, 29.69'
6) 8" Tamarack Stub, N75°W, 39.02' (Maines)
7) 8" Tamarack Windfall, N23°W, 21.78' (Maines)
8) Plastic sign post, next to monument

Distances to nail in side of BTs.
Stump blazes scribed "BT.

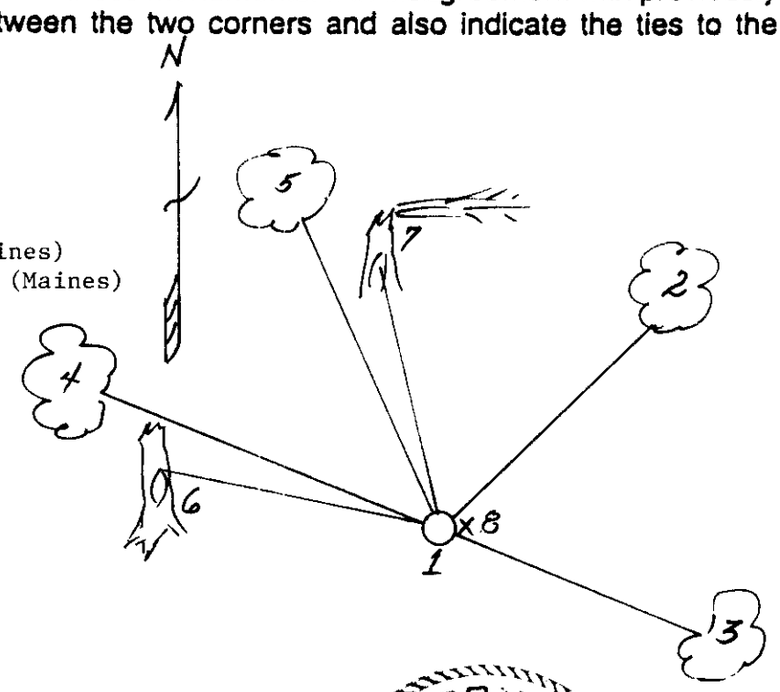

(i) I, Milo E. Stefan
(type or print name) certify that the corner location on this record was determined by me or under my direction and control and that this U.S. Public Land Survey Monument Record is correct and complete to the best of my knowledge and belief.

Milo E. Stefan 1/3/90
Signature **Date**

WISCONSIN MILO E. STEFAN S-1568 RHINELANDER, WIS. LAND SURVEYOR

Index No. X-25

3509136 2000

Stamp