

State of Wisconsin



County of Oneida } ss.

I, Phillip T. Hansen, do hereby certify that on the 11th day of October, 1978, I found evidence of the Quarter corner of Section 3 and 4 Township 35, North, Range 10 East, Fourth Principal Meridian, as described hereon; and that from this evidence I established a new monument and accessories as described hereon to perpetuate the original location of this corner.

Resident witnesses:

Jim Claflin

Herb Wagoner

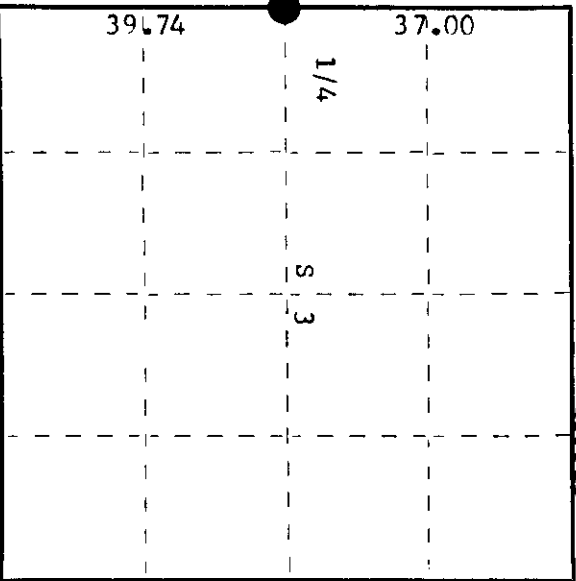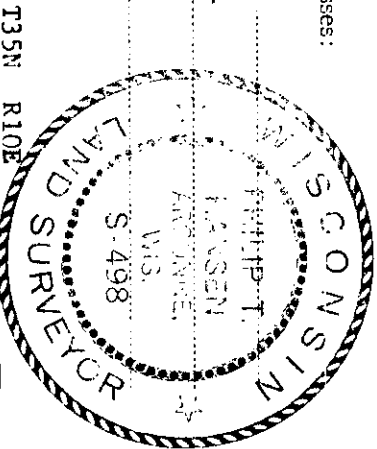

○ = Corner monument restored.

History of original corner establishment:

Original corner established by James L. Nowlin, Deputy Surveyor, in 1865 from which N.Pine 20" bears N 34° W 4 links; W.Pine 16" bears S 10° E 9 links. H.C. Lawrence, Registered Land Surveyor, recovered the stumps of original BT's in 1954. Set new 4" post and marked NBT's - W.Spruce 7" N65°W 23 1/2 links and a W.Spruce 9" N65°E 9 1/2 links.

Goddard and crew, Ripco surveyors, recovered Lawrence's post and BT's in 1961. Set new iron pipe with brass cap.

Description of corner evidence found:

Recovered Ripco's 2" iron pipe with 3" diameter alloy cap setting beside Lawrence's 4" squared cedar post, scribed 1/4S S3, 1/4S S4. Recovered Lawrence's B.Spruce 9" N61°W 23.5 links, scribed 1/4 S4 NBT. B.Spruce 10" N81°E 10.2 links, scribed 1/4 S3 NBT. Ripco's monument projected 24", stamped: S4 1/4 S3 RIPCO

Description of monument and accessories I established to perpetuate the original location of this corner.

Removed Lawrence's cedar post and set Ripco's iron pipe in its hole. Placed a large rock cairn around base of monument. Marked NBT's - Black Spruce 7" S36°W 18.3 links, scribed 1/4 BT. Black Spruce 6" N5°E 28.0 links, scribed 1/4 BT. Monument projects 2 1/2' above ground.

Dated at Rhineland, Wis., this 4th day of January, 1979.

Signature Phillip T. Hansen Title Registered Land Surveyor Registration No. S-498
(County Surveyor, Registered Land Surveyor, or other duly authorized official)

Office of Register of Deeds, County of Oneida, I hereby certify that the within instrument was filed in this office for record on the 25th day of January, 1979 at 11:50 o'clock P. M.

Dennis George Fuchs
(Register of Deeds)

By: _____ Deputy

3510042000