

CERTIFIED LAND CORNER RESTORATION

Index No. **E-2**

State of Wisconsin }
County of Oneida } ss.



I, Phillip T. Hansen, do hereby certify that on the 1st day of April, 1976, I found evidence of the 1/4 corner of Section 6 ar. 7 Township 35, North, Range 10 East, Fourth Principal Meridian, as described hereon, and that from this evidence I established a new monument and accessories as described hereon to perpetuate the original location of this corner.

Resident witnesses:

Glen Barker

Jim Mueller

Harb. ...

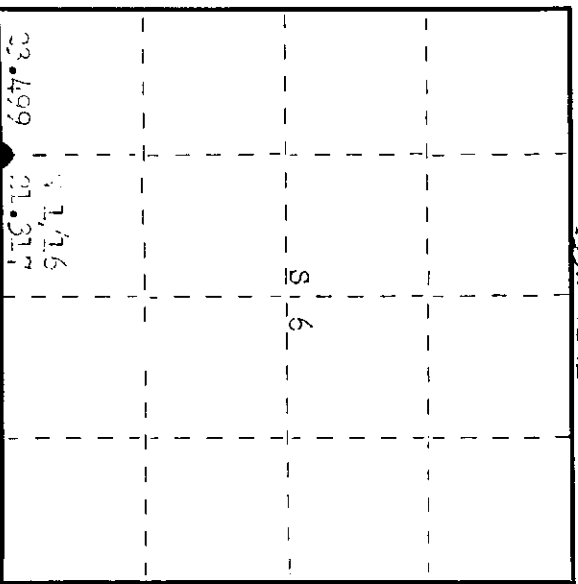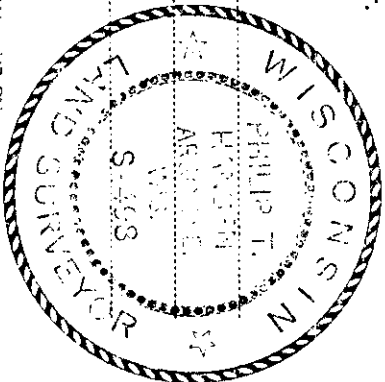

○ = Corner monument restored.

CERTIFIED LAND CORNER RESTORATION

Index No. **E-2**

History of original corner establishment: Corner established by H. G. Lawrence, Registered Land Surveyor, in 1949. Set corner 21.34 chains N 79° 10' W of 1/4 corner. Corner restored by Rigo surveyor (Onions) in 1969 - Ran random line N 79° 14' 50" W from 1/4 corner between section 6 & 7 to section corner, distance 44.765 chains. Set N 1/4 corner at 21.317 chains, projected against government notes marked by - a pine 120' N 40° 01' E. Set iron pin in road. Established reference pipe 30 lks south, corrected bearing of line N 79° 25' 13" W.

Description of corner evidence found: Recovered pipe in road below surface. Recovered 1" aluminum pipe with aluminum cap 30 lks south of corner, cap stamped. Pipe projects 12" above ground. Recovered 1/4" (N 46° W) 91 lks section N 1/4 S of N 1/4. Cor. 20 lks recovered 08T - a pipe 120' N 40° 01' E. North. Align

Description of monument and accessories I established to perpetuate the original location of this corner.

The pipe located in ground and the witness monument were recovered in good condition, we left in place. 08T - a pipe 8" 35° 36.8 lks, located 1/16 T. Witness monument and 08T painted blue. No additional accessories established.

Dated at Mineralander, Wis. this 1st day of April, 1976.

Signature Phillip T. Hansen Title Registered Land Surveyor Registration No. 5468
(County Surveyor, Registered Land Surveyor, or other duly authorized official)

Office of Register of Deeds, County of Oneida. I hereby certify that the within instrument was filed in this office for record on the 10th day of April, 1976 at 2:00 o'clock P. M.

James H. ...
(Register of Deeds)

By James H. ... Deputy

3510060030