

CERTIFIED LAND CORNER RESTORATION

Index No. H-3

History of original corner establishment: Corner established by riproo surveyors in 1962. ran north 1° 35' 58" W from  $\frac{3}{4}$  between Section 7 and 18. Set SC 1/16 at 21.29 chains set pin in road and marked BTs - Maple 9" S60° 83 lks and 4" post N 12° 34 lks.

Description of corner evidence found: From calls from BT and 4" post, located pin in gravel road (Shingle Mill road).

Recovered OBT - Maple 9" S60°, 83 lks, scribed OS 1/16 BT.  
4" cedar post, N12° 34 lks.

Description of monument and accessories I established to perpetuate the original location of this corner.

Set a 1" OD iron pipe with 2" brass cap for witness corner N65° W - 35 lks.  
Pipe projects 18" above ground. Cap stamped.  
NBT - sugar 7" S31° W 145.8 lks, scribed 1/16 BT.  
Measurement and bearing to true corner.  
Witness corner and BT painted blue.

S498  
 T35N R10E  
 SC 1/16  $\frac{3}{4}$  W.C.  
 S65° W 35 lks  
 CPL-1976



State of Wisconsin

County of Oneida } ss.

I, Phillip F. Hansen, do hereby certify that on the 31st day of March, 1976, I found evidence of the SC 1/16 corner of Section 7 Township 35, North, Range 10 East, Fourth Principal Meridian, as described hereon; and that from this evidence I established a new monument and accessories as described hereon to perpetuate the original location of this corner.

Resident witnesses:

- Glen Barker
- Jim Claflin
- Herb Wagoner

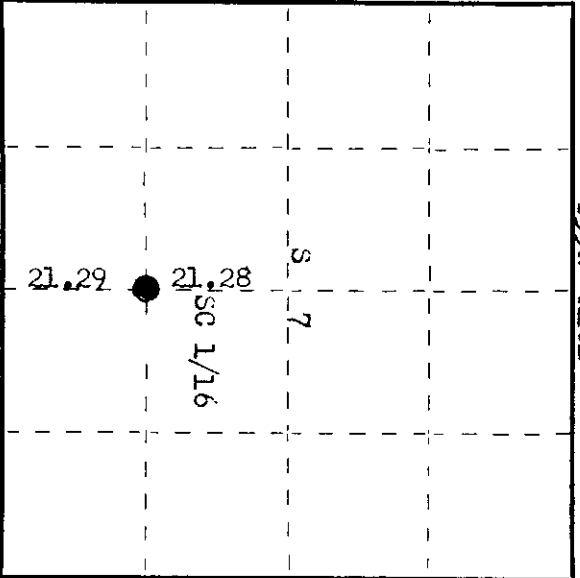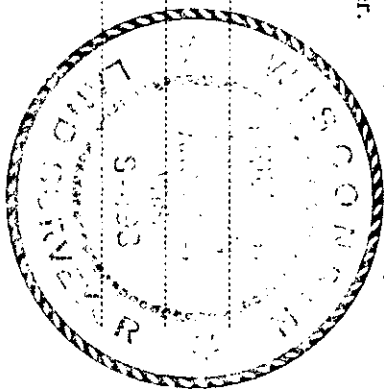

○ = Corner monument restored.

Dated at rhinelander, Wis., this 19th day of May, 1976

Signature Phillip F. Hansen Title Registered Land Surveyor Registration No. S-498  
(County Surveyor, Registered Land Surveyor, or other duly authorized official)

Office of Register of Deeds, County of Oneida, I hereby certify that the within instrument was filed in this office for record on the 1st day of May, 1976 at 2:00 o'clock P.M.

Wanda L. Kiser  
(Register of Deeds)

By: \_\_\_\_\_ Deputy

3510071020