

CERTIFIED LAND CORNER RESTORATION

Index No. J-15

State of Wisconsin



County of Oneida } ss.

I Phillip T. Hansen, do hereby certify that on the 10th day of October, 1978, I found evidence of the Quarter corner of Section 10 & 15 Township 35, North, Range 10 East, Fourth Principal Meridian, as described hereon; and that from this evidence I established a new monument and accessories as described hereon to perpetuate the original location of this corner.

Resident witnesses:

Jim Clafflin

Herb Wagoner

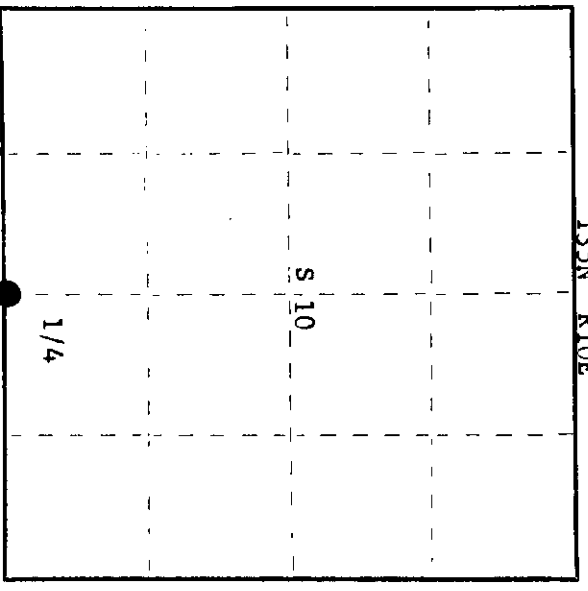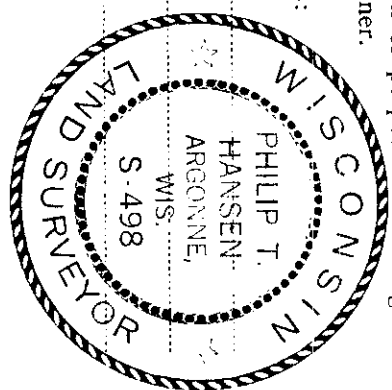

○ = Corner monument restored.

History of original corner establishment:

Original corner established by Hiram C. Fellows, Deputy Surveyor, in 1859, from which tamarack 8" bears N53°E, 15 links and tamarack 6" bears S15°W, 12 links.

H.C. Lawrence, Registered Land Surveyor, recovered the original BT's in 1960 and reset the corner.

Marked NBT's -

cedar 8" S25°W, 39 links

tamarack 4" N56°E 47 1/2 links

tamarack stump 8" was found to be N33°E, 15.0 links

Description of corner evidence found:

Recovered H.C. Lawrence's 5" square cedar post scribed 1/4S, S10, 1/4S S15 in fair condition.

Recovered old original tamarack 8" stump, badly decayed, N33°E, 15.0 links

Recovered Lawrence's BT's - tamarack 6" N63°E, 47.8 links, scribed 1/4S BT. cedar 12" S24°W, 39.5 links, scribed 1/4S NBT.

Description of monument and accessories I established to perpetuate the original location of this corner.

Replaced Lawrence's wood post with 2 1/2" Bernitsen A-1 Federal Monument, cap stamped:

Monument projects 8" above ground.

Marked NBT's - B.Spruce 7" S5°E 16.0 links

B.Spruce 6" N30°W 22.2 links

both scribed 1/4 BT

S498-1978  
T35N R10E  
1/4 S 10  
S 15

Dated at Rhinelander, Wis., this 18th day of October, 1978

Signature Phillip T. Hansen Title Registered Land Surveyor Registration No. S-498  
(County Surveyor, Registered Land Surveyor, or other duly authorized official)

Office of Register of Deeds, County of Oneida I hereby certify that the within instrument was filed in this office for record on the 6th day of November, 1978 at 10:00 o'clock A. M.

Doris George Kuehn  
(Register of Deeds)

By..... Deputy

351010020