

CERTIFIED LAND CORNER RESTORATION

Index No. H-18

State of Wisconsin } ss.  
County of Oneida

I Phillip T. Hansen do hereby certify that on the 9th day of October, 1978, I found evidence of the SW 1/16 corner of Section 11



Township 35, North, Range 10 East, Fourth Principal Meridian,

as described hereon; and that from this evidence I established a new monument and accessories as described hereon to perpetuate the original location of this corner.

Resident witnesses:

Jim Claflin

Herb Wagoner

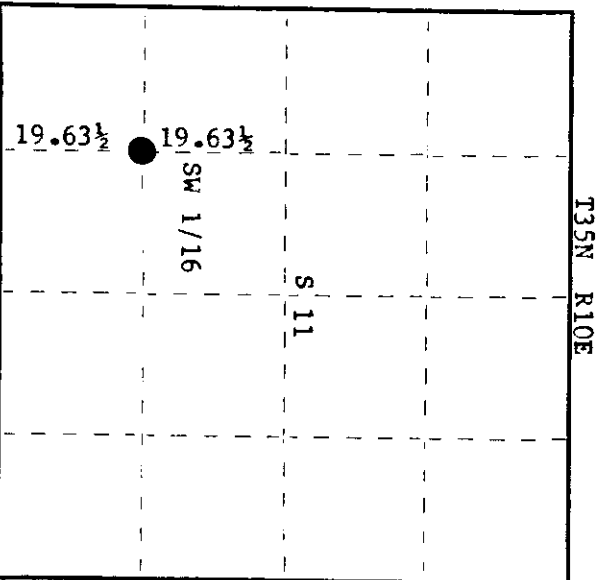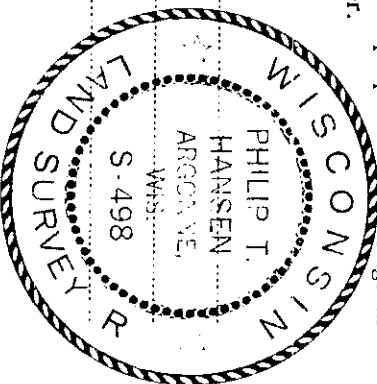

○ = Corner monument restored.

History of original corner establishment:

Corner established by N. Loftus, Ripco surveyor, in 1961. Ran random line north bearing 357° 24' magnetic from W 1/16 corner on south line, 39.27 chains to close out 40.2 links east of the C-W 1/16. Set SW 1/16 corner at 19.63 1/2 chains, 20.1 links west.

Marked NBT's -  
Tamarack 5" N81°E 25 links  
Tamarack 4" S47°E 37 1/2 links

Description of corner evidence found:

Recovered 3/4" iron pipe with 2" brass cap in excellent condition. Cap stamped: Monument projects 1 1/2' above ground. Recovered Tamarack 5" N81°E, scribed SW 1/16 S11 BT (now a stump) Tamarack 4" S47°E, 37.5 links (37.0 lks), scribing grown over S11 SW 1/16 RIPCO

Description of monument and accessories I established to perpetuate the original location of this corner. Left recovered monument in place. Marked NBT - Oak 7" N9°W, 13.5 links, scribed 1/16 BT.

Dated at Rhineland, Wis., this 18th day of October, 1978.

Signature Phillip T. Hansen Title Registered Land Surveyor Registration No. S-498  
(County Surveyor, Registered Land Surveyor, or other duly authorized official)

Office of Register of Deeds, County of Oneida.  
Instrument was filed in this office for record on the 6th day of November, 1978 at 10:00 o'clock A. M.

Doris Leauge Kuehn  
(Register of Deeds)

By: \_\_\_\_\_ Deputy

3510111030