



CERTIFIED LAND CORNER RESTORATION

Index No. **V-24**

State of Wisconsin } ss.
 County of Oneida

I, Phillip T. Hansen, do hereby certify that on the 8th day of April, 1976, I found evidence of the corner of section 25 and 36 of Township 35 North, Range 10 East, Fourth Principal Meridian, as described hereon; and that from this evidence I established a new monument and accessories as described hereon to perpetuate the original location of this corner.

Resident witnesses:
 Glen Barker
 Jim Clafflin
 Herb Wagoner

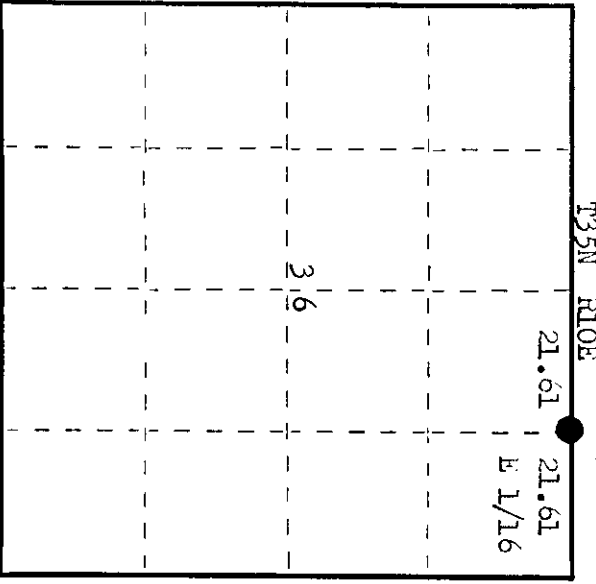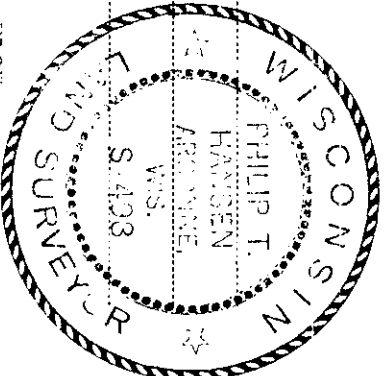

O = Corner monument restored.

History of original corner establishment: Line between section 25 and 36 run by H.C. Lawrence, registered land surveyor, in 1952. Commenced at recovered 1/4 corner set by J.H. Vaughan in 1907, which was 1/16" on the ground. He measured the total distance to true section corner and arrived at a point 140 south of corner at 43.22 chains. Set new post at 21.61 chains e, distant and 73 lks north. Set 4" cedar post, squared and scribed.

Description of corner evidence found:
 recovered 4" cedar post, squared and scribed, 325, ± 1/16, 330, ± 1/10. Also found a 1 1/2" iron pipe setting beside it. Post was in very poor condition. No OBTS were recovered.
 Corner sets east of old highway 45 and west of new highway 45.

Description of monument and accessories I established to perpetuate the original location of this corner.
 Replaced old cedar post with 1 1/2" iron pipe with 2" brass cap stamped.
 Monument projects 13" above ground.
 No trees suitable for BTs.
 Set two 1 1/2" iron pipes for witness monuments.
 #1 - 1 1/2" x 5' iron pipe west 35 lks.
 #2 - 1 1/2" x 5' iron pipe north 30 lks.
 Project 2' above ground.
 All monuments painted blue.

3498
 T35N R10E
 E 1/16 S 25
 26
 CPI - 1976

Dated at Oneida, Wis., this 12th day of July, 1976.
 Signature: *Phillip T. Hansen* Title: Registered Land Surveyor Registration No. S-498
 County Surveyor, Registered Land Surveyor, or other duly authorized official

Office of Register of Deeds, County of Oneida
 Instrument was filed in this office for record on the 23rd day of July, 1976 at 10:00 o'clock M.
 Signature: *Terrie LePage Freeman*
 (Register of Deeds)

By: _____ Deputy

3510250010