


Oneida County  
Land Information Office  
Filed  
1/12/2026

# U.S. PUBLIC LAND SURVEY MONUMENT RECORD

NOTE: This form is intended and designed to fulfill all requirements of Wisconsin Administrative Code, Chapter A-E 7.08 U.S. Public Land Survey Monument Record (3) (a-i)

A-E 7.08(3)(a) Identity of corner:  
South 1/4 Corner Section 28,  
Township 35 North, Range 10 East  
of the Fourth Principal Meridian,  
Town of Enterprise, Oneida County, Wisconsin

WISCRS - ONEIDA COUNTY  
N: 108,445.134 USft (XXX,XXX.XXX)  
E: 306,068.150 USft (XXX,XXX.XXX)  
Datum: NAD83 (2011)  
GNSS Method RTN  
GNSS Control WISCORS VRS

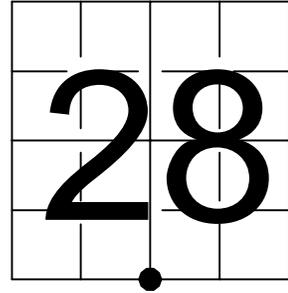

The coordinate value shown has been verified by the average of two or more GPS observations at a markedly different time. Coordinates shown in parenthesis are previously published values.

A-E 7.08(3)(b)

Original Surveyor: James L. Nowlin - September 22, 1865 to October 2, 1865  
Cedar 8 - S 73° W, 6 Links, Tamarac 12 - N 16° W, 10 Links


THENCE:

- April 3, 2000 - Surveyor 1795 - Devon Vanden Heuvel - indicates this position as "found 3"x3" wood stake reset county monument" on county record map #C1783.
- October 25, 2001 - Surveyor 1451 - Eugene C. Uttech - indicates this position as "county monument found" on county record map #A3774.

December 17, 2025 - I found a 2.4" diameter aluminum pipe monument with a 3.25" diameter aluminum cap (not stamped). I also found 1 bearing tree of unknown origin, as well as faded blue and red paint on nearby trees. The monument is in a cedar swamp and is flush with grade.

I established 4 new reference monuments as shown below.

A-E 7.08(3)(c)(d) Plan view of corner with references to at least 4 witness monuments.

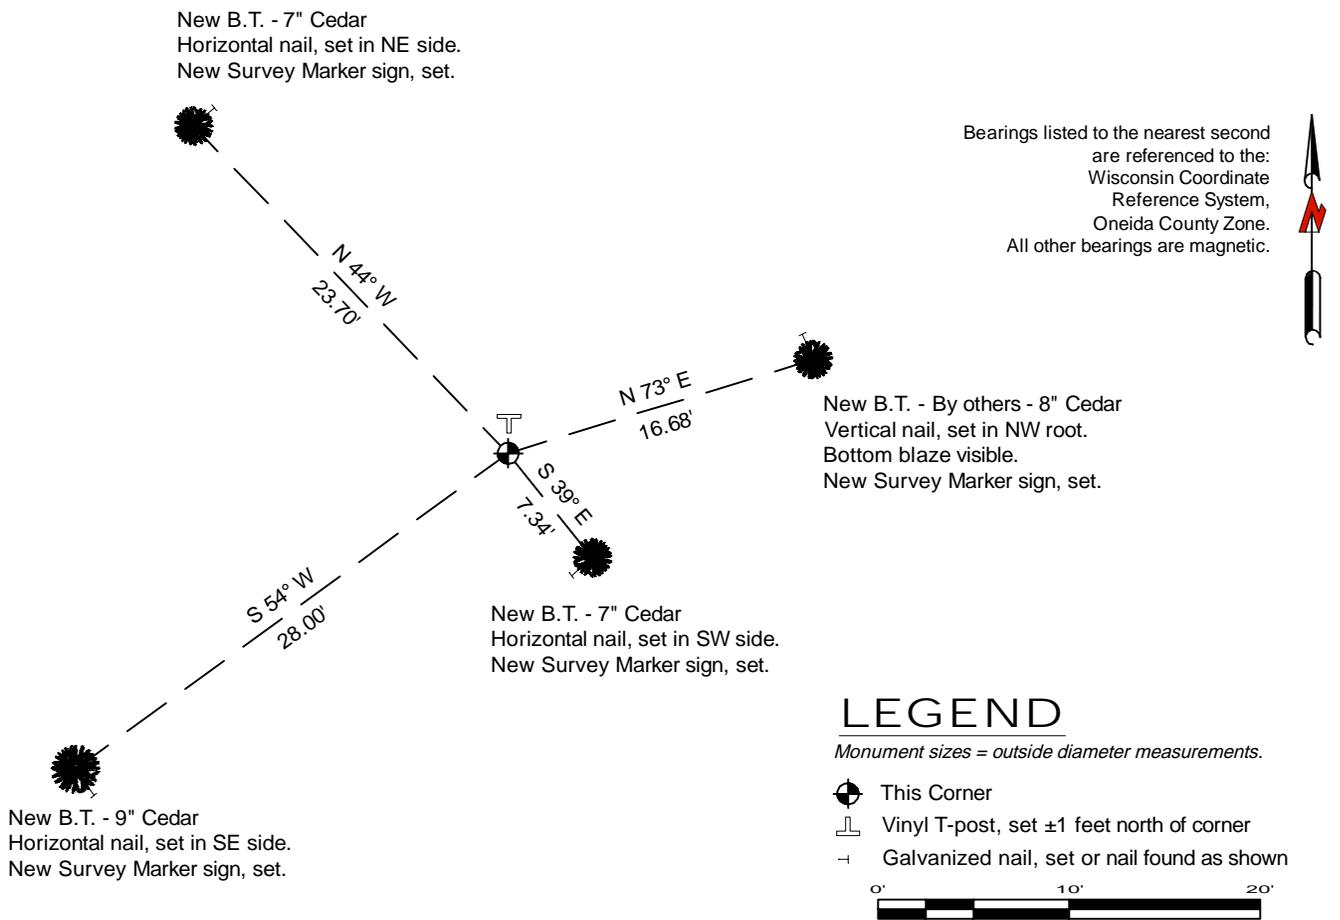


A-E 7.08(3)(e) 1865 Surveyor set a post, 2000 Surveyor found a wood post and replaced with a county monument, 2001 Surveyor found the same, as did I in 2025.

A-E 7.08(3)(f) I accept this monument in good faith as a FOUND PERPETUATED LOCATION of the corner.

A-E 7.08(3)(g)(h) This corner was not determined through lost-corner-proportionate methods.

A-E 7.08(3)(i) I, Jeffrey L. DeMuth, Professional Land Surveyor No. S-2656, hereby certify that the corner location on this record was determined by me or under my direction and control, and that this U.S. Public Land Survey Monument Record is correct and complete to the best of my knowledge, and belief.

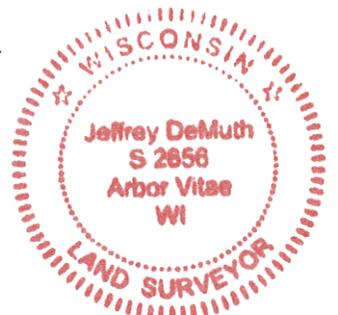

*Jeffrey L. DeMuth*  
December 18, 2025

SIGNATURE

DATE

43510280020