

CERTIFIED LAND CORNER RESTORATION

Index No. W-24

State of Wisconsin

County of Oneida } ss.

I Phillip T. Hansen, do hereby certify that on the 8th day of April, 1976, I found evidence of the NE 1/16 corner of section 36 Township 35, North, Range 10 East, Fourth Principal Meridian.


as described hereon; and that from this evidence I established a new monument and accessories as described hereon to perpetuate the original location of this corner.

Resident witnesses:

Glen Barker

Jim Claffin

Herb Wagoner

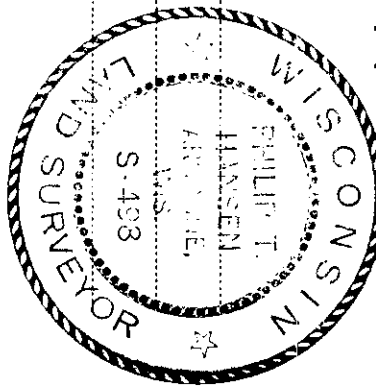

History of original corner establishment: Corner established by H.C. Lawrence, registered land surveyor, in 1957. From established N 1/16 between Sec. 25 and 30 and the W 1/16 corner section 36. Set the corner 19.77 chains south of N 1/16 corner and 21.35 chains east of W 1/16 corner. It is in east shoulder of new Highway 45. Set 4" cedar post, squared and scribed.

Description of corner evidence found: Recovered 4" cedar post, squared and scribed NE 1/16 S 30, NE 1/16 S 30 in fair condition. A small rock cairn found around base. No old BTs were visible.

Description of monument and accessories I established to perpetuate the original location of this corner.


As this corner sets in the N.C.M. of Highway 45, a 1 1/2" iron pipe was set in the hole of the old post, below ground level. Set a 1 1/2" iron pipe with brass cap, for fitness corner 45 lks east. Cap stamped.

Marked MBTs - Sugar 8" S 37° S 38.4 lks, scribed 1/16 BT. Henlock 12" N 70° S 195.0 lks, scribed 1/16 BT.

Bearings and measurements made to true corner. Corner sets 65 lks east of centerline of th 45

N.C. & BTs painted blue.

S 498
T35N R10E
NE 1/16 S 36 N.C.
" 45 lks.
CPI-1976

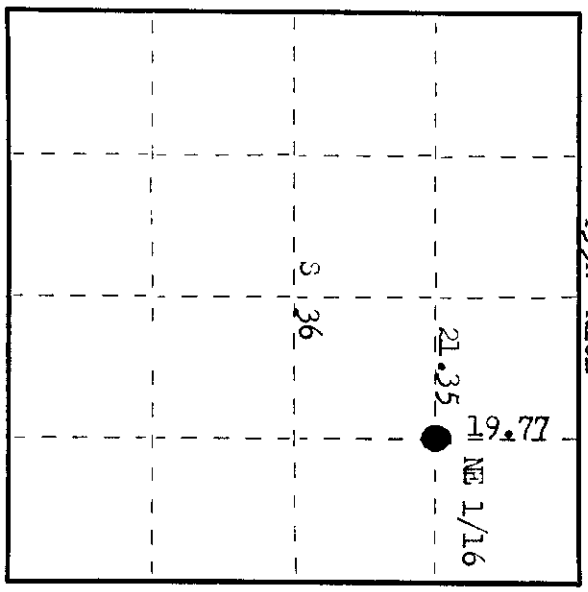

O = Corner monument restored.

Dated at Rhinelander, Wis., this 12th day of July, 1976.

Signature Phillip T. Hansen Title Registered Land Surveyor Registration No. S-498
(County Surveyor, Registered Land Surveyor, or other duly authorized official)

Office of Register of Deeds, County of Oneida. I hereby certify that the within instrument was filed in this office for record on the 23rd day of July, 1976 at 1:00 o'clock P.M.

Debra Neuge-Kuehn
(Register of Deeds)

By: _____ Deputy

3510363010