

CERTIFIED LAND CORNER RESTORATION

Index No. **B-23**

State of Wisconsin





Resident witnesses:

John A. Brown

Ed. G. Brown

John A. Brown

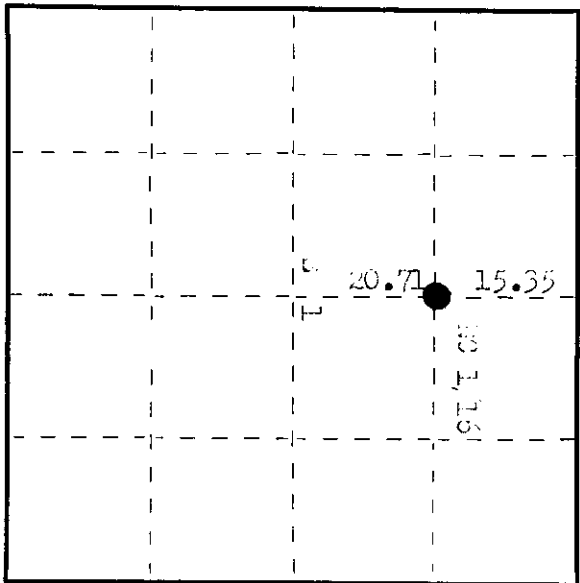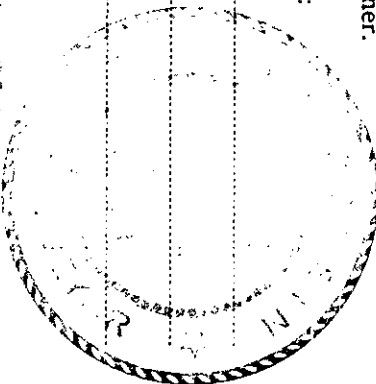

○ = Corner monument restored.

History of original corner establishment:



Description of corner evidence found:


Description of monument and accessories I established to perpetuate the original location of this corner.

Replaced 4" benchmark post with 1" 1/2" iron pipe with 1" brass cap, stamped: 3476
monument projects 4" above ground. 23 1/2" 11"
1 1/2" - 1/2" diameter, 21" 20" lines, section 1, 10 21.
set and post beside new monument. 10 1/10 21
21-1976

Dated at Waushara, Wis., this 17th day of October, 1976

Signature Julio P. Stamen Title Registered Land Surveyor Registration No. 4473
(County Surveyor, Registered Land Surveyor, or other duly authorized official)

Office of Register of Deeds, County of Waushara I hereby certify that the within instrument was filed in this office for record on the 7th day of December, 1976 at 11:00 o'clock A. M.

By David Thomas Kuehn (Register of Deeds)
Joseph M. Berner Deputy

3511013020