

CERTIFIED LAND CORNER RESTORATION

Index No. E-17

State of Wisconsin

County of Oneida } ss.


I Philip T. Hansen, do hereby certify that on the 12th day of October, 1976, I found evidence of the Section corner of S 2 - 3, 10, 11 Township 35, North, Range 11, Fourth Principal Meridian, as described hereon; and that from this evidence I established a new monument and accessories as described hereon to perpetuate the original location of this corner.

Resident witnesses:

Glen Barker


Jim Claflin

Herb Wagoner

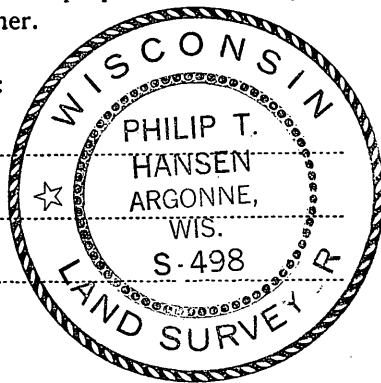

FORM 985 Wisconsin Printing & Binding Co. Madison, Wisconsin

T35N R11E

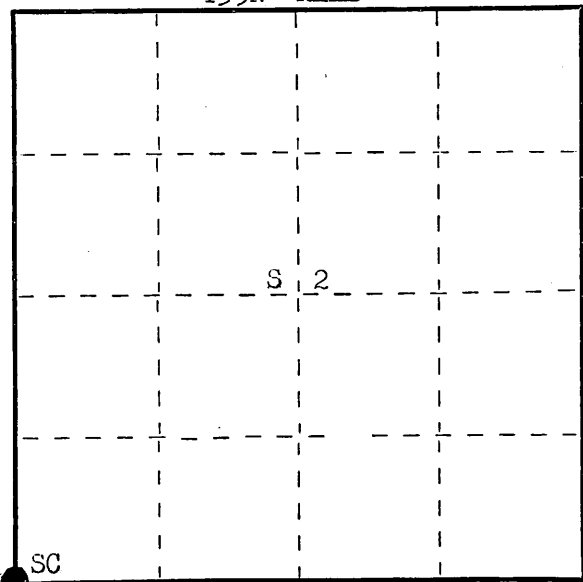

○ = Corner monument restored.

History of original corner establishment:

Original Corner established by Wm. E. Dougherty, Deputy Surveyor, in 1859, from which White Pine 10" bears S 4° E 40 links, White Pine 12" bears N 66° E 11 links. H.C. Lawrence looked for this corner in 1954. Wm. Meisler, who lived in SW 1/4 of NE 1/4, told him that an iron pipe was buried in the centerline of E-W road, and that the road north was not on line. A fence line runs due south from the E-W road. Lawrence was unable to locate corner. He believed corner was in line with this fence.

Description of corner evidence found:

Recovered 1 1/2" iron pipe buried in centerline of E-W road, 14" below the surface. An old line fence runs due south from this corner. Found an old charred pine stump to the southeast on old south fence line in E-W road.

Description of monument and accessories I established to perpetuate the original location of this corner.

Set a 2 1/2" iron pipe with brass cap for a witness corner S 20° E 50 links. Monument projects 24" above ground. Cap stamped:
Marked BO - Power pole 3511-10E1 due south 35.3 links
Power pole 3511-10E20 S 83° W 175.1 links
NE corner cottage S 28° W 119 links
Measurements and bearings made to true corner.

S498
T35N R11E
Sec. 3/12 W.C.
N 20° W 50 lks. to Cor.
CPI - 1976

Dated at Rhineland, Wis., this 24th day of November, 1976.

Signature Philip T. Hansen Title Registered Land Surveyor Registration No. S-498
(County Surveyor, Registered Land Surveyor, or other duly authorized official)

Office of Register of Deeds, County of Oneida. I hereby certify that the within instrument was filed in this office for record on the 7th day of December, 1976 at 11:00 o'clock a M.

Doris Verage Kuehn
(Register of Deeds)

By Joseph M. Boomer Deputy

3511030000