


CERTIFIED LAND CORNER RESTORATION


Index No. E-10

State of Wisconsin }
County of _____ } ss.

I _____, do hereby
certify that on the _____ day
of _____, 19____, I found
evidence of the _____
corner of _____
Township _____, North, Range
_____ Fourth Principal Meridian,
as described hereon; and that from this evidence
I established a new monument and accessories
as described hereon to perpetuate the original
location of this corner.

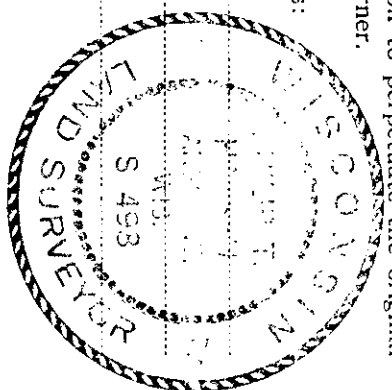

Resident witnesses:

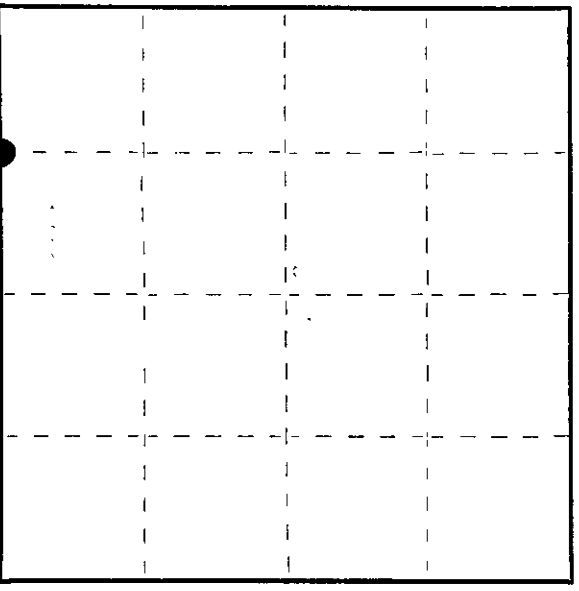

○ = Corner monument restored.

History of original corner establishment:

Description of corner evidence found:

Description of monument and accessories I established to perpetuate the original location of this corner.

Dated at _____ Wis., this _____ day of _____, 19____

Signature Walter A. Starnes Title _____ Registration No. _____
(County Surveyor, Registered Land Surveyor, or other duly authorized official)

Office of Register of Deeds, County of _____
Instrument was filed in this office for record on the _____ day of _____, 19____
at _____ o'clock _____ M.

Doris Verage Kuehn
(Register of Deeds)

By _____ Deputy

3511040030