

CERTIFIED LAND CORNER RESTORATION



Index No. **G-23**

State of Wisconsin

County of Oneida } ss.

I, Philip T. Hansen, do hereby certify that on the 29th day of May, 1975, I found evidence of the C-1/4 corner of Section 12 Township 35, North, Range 11 East, Fourth Principal Meridian, as described hereon; and that from this evidence I established a new monument and accessories as described hereon to perpetuate the original location of this corner.

Resident witnesses:

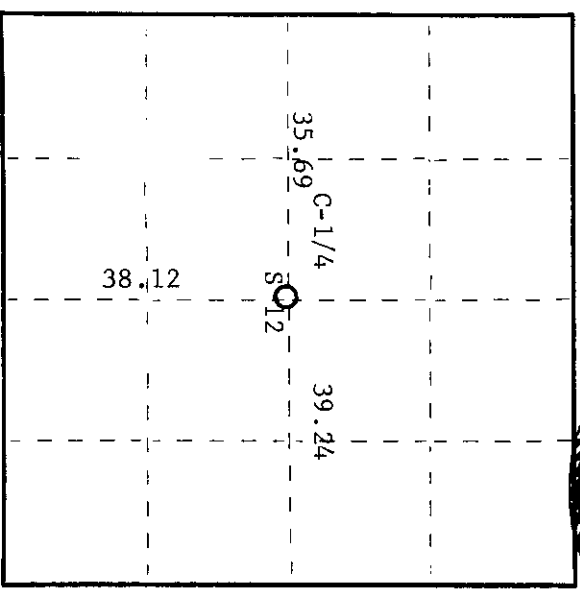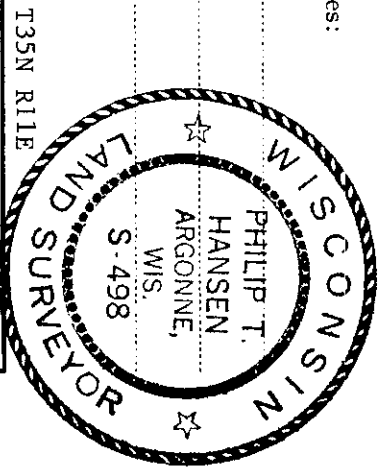

O = Corner monument restored.

History of original corner establishment:

This corner was established by D.H. Vaughan in 1914. He claims he re-established the W-1/4 from original trees, but returned no notes on this. Corner was re-established by H.C. Lawrence, Registered Land Surveyor, in 1959. He set an iron pipe at the intersection of the N-S 1/4 and E-W 1/4 line, from which white birch 12' bears S77°W 48-1/2 links and black cherry 8" bears N64°W 41-1/2 links. This corner is 39.24 chains west of E 1/4 line on range line.

Description of corner evidence found:

Extensive search was made for iron pipe set by H.C. Lawrence, but was unable to recover the iron pipe. Recovered OBT - white birch 12" (14) S77°W 48.5 links, scribed C-1/4S BT. Also, black cherry 8" N64°W 41.5 links, scribed S12 BT (now dead).

Description of monument and accessories I established to perpetuate the original location of this corner.

Re-established corner in road from Lawrence's BT. Set a 1-1/2" x 18" iron pipe driven flush with the ground.

Set a 2-1/2" iron pipe with brass cap 55 links west as a witness corner, stamped -

NBT - basswood 9" N41°W 65.7 links, scribed 1/4 BT. Reference to true corner.

C-1/4 S 1/2 W.C.

CPI-1975
E-55 links

Dated at Rhineland, Wis., this 13th day of June, 1975

Signature Philip T. Hansen Title Registered Land Surveyor Registration No. S-498
(County Surveyor, Registered Land Surveyor, or other duly authorized official)

Office of Register of Deeds, County of Oneida I hereby certify that the within instrument was filed in this office for record on the 1st day of October, 1975 at 3:00 o'clock P. M.

Dora Savage Truehan
(Register of Deeds)

By Dora Savage Truehan Deputy

351122020