

CERTIFIED LAND CORNER RESTORATION

Index No. L-12

State of Wisconsin

County of Oneida } ss.

I Phillip T. Hansen, do hereby

certify that on the 15th day

~~established~~ re-established the EC 1/16

corner of Section 16

Township 35, North, Range

11 East, Fourth Principal Meridian,

as described hereon; and that from this evidence

I established a new monument and accessories

as described hereon to perpetuate the original


location of this corner.

Resident witnesses:

Glen Barker

Jim Clafflin


Herb Wagoner

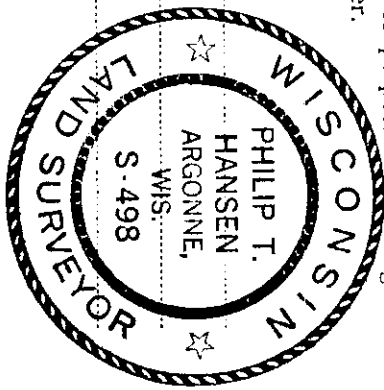

T35N R11E

S 16 EC 1/16

1356.709 1356.709

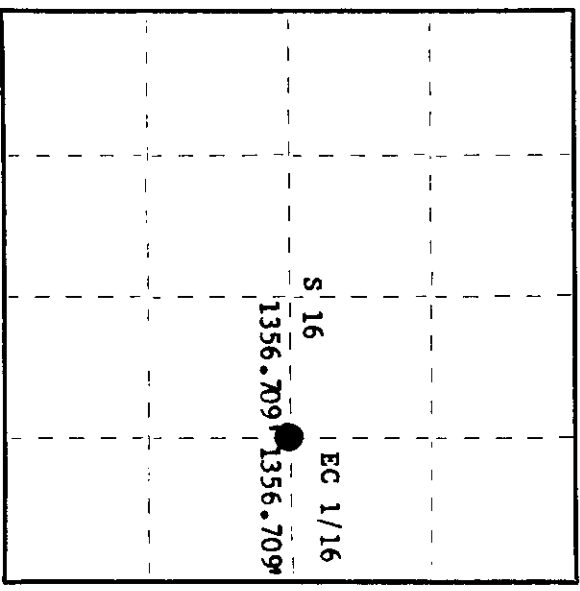

○ = Corner monument restored.

History of original corner establishment:
No records of any previous survey.

Description of corner evidence found:

No evidence of any corner recovered.

Corner established by traverse and computation. Ran E-W and N-S 1/4 lines from previously established 1/4 corners to locate the C 1/4 corner. Computed distance from E 1/4 to C 1/4 corner is 2713.418 feet at bearing S 89° 10' 45" W. Set EC 1/16 at 1356.709' intermediate.

Description of monument and accessories I established to perpetuate the original location of this corner.

Set 1 1/2" iron pipe with 2" brass cap for corner, projecting 24" above ground.

Cap stamped:

Marked NBT's

Sugar 6" S77°W, 13.40 feet

Sugar 7" S87°E, 38.76 feet, scribed 1/16 BT.

S498

T35N R11E

EC 1/16 S116

CPI-1978

Dated at Rhinelander, Wis., this 30th day of May, 19 78

Signature Phillip T. Hansen Title Registered Land Surveyor Registration No. S-498

(County Surveyor, Registered Land Surveyor, or other duly authorized official)

Office of Register of Deeds, County of Oneida I hereby certify that the within instrument was filed in this office for record on the 13th day of June, 19 78 at 2:34 o'clock P. M.

Doris Verage Kuehl
(Register of Deeds)

By Joseph M. Brown Deputy

351162010