


CERTIFIED LAND CORNER RESTORATION

Index No. L-5


State of Wisconsin

County of Oneida } ss.

I Philip T. Hansen, do hereby certify that on the 21st day of May, 1975, I found evidence of the 1/4 corner of Section 17 and 18 Township 35N, North, Range 11 E, Fourth Principal Meridian, as described hereon; and that from this evidence I established a new monument and accessories as described hereon to perpetuate the original location of this corner.

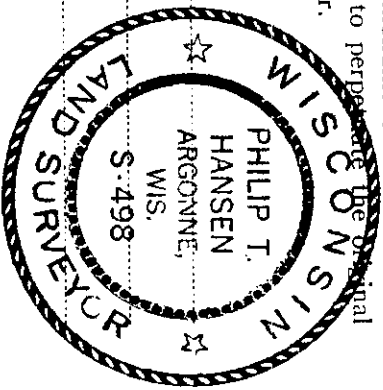

Resident witnesses:

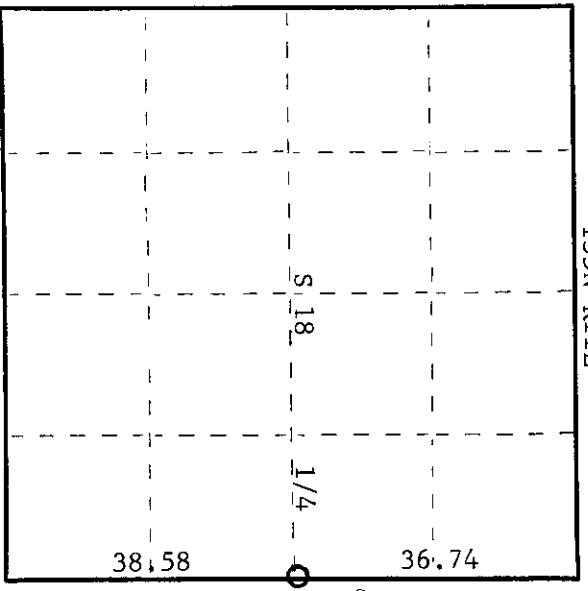

○ = Corner monument restored.

History of original corner establishment:

Original corner established by Wm. E. Dougherty, Govt. Deputy Surveyor, in 1859. Tamarack 8" bears N41°E, 3 links and tamarack 8" bears S49°W, 8 links. These BT's are duplicates of BT's given for 1/4 corner between Sec. 17 and 18. They apparently were the correct BT's for this corner. Corner recovered by H.C. Lawrence in 1953. He found the S49°W tamarack broken off, from which he chopped out the scribe marks and found the remains of old stump for the N41°E BT. From these BT's he intersected and by digging found the remains of point of old post deep in the muck. He set 4" cedar post from which white pine 24" bears N56°W, 66 links and white birch 18" bears N70°E, 28-1/2 links.

Description of corner evidence found:

Recovered 4" cedar post, squared and scribed 1/4S S17, 1/4S S18. Also found 2-1/2" iron pipe w/brass cap sitting beside wooden stake. Both in good condition.

Description of monument and accessories I established to perpetuate the original location of this corner.

Replaced wooden post with 2-1/2" iron pipe w/brass cap stamped -

S498  
T35N R11E

While digging out the old post hole, found the remains of the two old points referred to above.

NBT: Hemlock 17" N70°E 41.7 links scribed 1/4BT

S18|S17  
1/4  
CPT-1975

Dated at Rhineland Wis., this 6th day of June, 1975

Signature Philip T. Hansen Title Registered Land Surveyor Registration No. S-498  
(County Surveyor, Registered Land Surveyor, or other duly authorized official)

Office of Register of Deeds, County of Oneida hereby certify that the within instrument was filed in this office for record on the 1st day of October, 1975 at 3:00 o'clock P. M.

Doris Verage Kuehn  
(Register of Deeds)

By Doris Verage Kuehn Deputy

3511B2000