

CERTIFIED LAND CORNER RESTORATION



Index No. Q-12

State of Wisconsin }
County of Oneida } ss.

I Phillip T. Hansen, do hereby certify that on the 28th day of June, 1978, I ~~restored~~ established the SE 1/16 corner of Section 21 Township 35, North, Range 11 East, Fourth Principal Meridian, as described hereon; and that from this evidence I established a new monument and accessories as described hereon to perpetuate the original location of this corner.

Resident witnesses:

- Glen Barker
- Jim Claflin
- Herb Wagoner
- John Masbaum

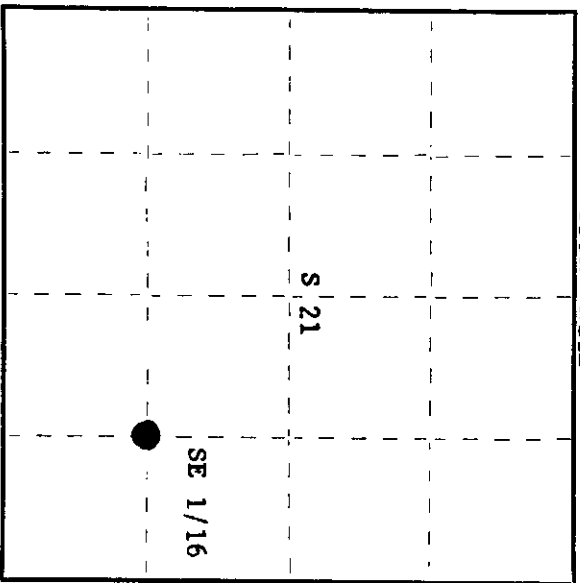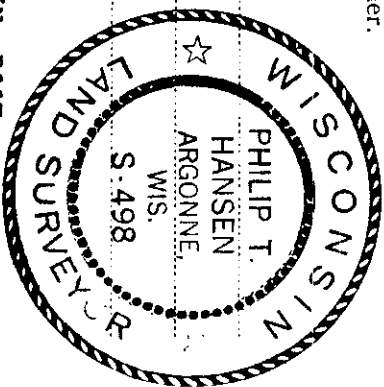

○ = Corner monument restored.

History of original corner establishment:

No records of any previous survey.

Description of corner evidence found:

No evidence of any corner recovered. Corner established by traverse and computations. Computed distance between E 1/16, section 21 and 28 and EC 1/16 is 2591.644 feet at bearing N 0° 30' 23" E. Computed distance of SE 1/16 corner is 1295.921 feet north 0° 30' 23" E of E 1/16 and 1295.723 S 0° 30' 23' W of EC 1/16.

Description of monument and accessories I established to perpetuate the original location of this corner.

- Set a 1 1/2" iron pipe with 2" brass cap, stamped: S498
- Monument projects 24" above ground. T35N R11E
- Marked NBT's -
- White Birch 5" S22°W, 27.95 feet SE 1/16 S 21
- White Spruce 6" S75°W, 16.18 feet, scribed 1/16 BT CPI-1978

Dated at Rhineland, Wis, this 5th day of July, 1978

Signature Phillip T. Hansen Title Registered Land Surveyor Registration No. S-498
(County Surveyor, Registered Land Surveyor, or other duly authorized official)

Office of Register of Deeds, County of Oneida, I hereby certify that the within instrument was filed in this office for record on the 14th day of August, 1978 at 10:45 o'clock P. M.

Terrie Savage Kuehn
(Register of Deeds)

By: _____ Deputy

3511211010