

CERTIFIED LAND CORNER RESTORATION

Index No. **P21**

State of Wisconsin

County of Cneida } ss.



I, Philip T. Jensen, do hereby certify that on the 19th day of September, 1977, I found evidence of the Quarter corner of Section 23 & 24 Township 35, North, Range 11 East, Fourth Principal Meridian,

as described hereon; and that from this evidence I established a new monument and accessories as described hereon to perpetuate the original location of this corner.

Resident witnesses:

Jim Staffin

Herb Johnson

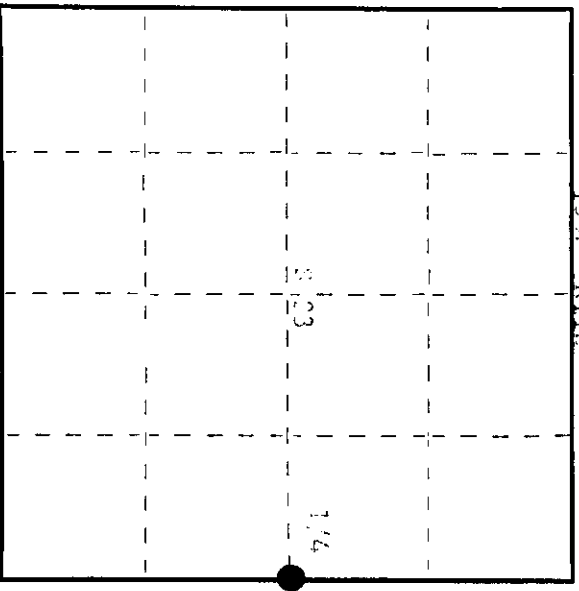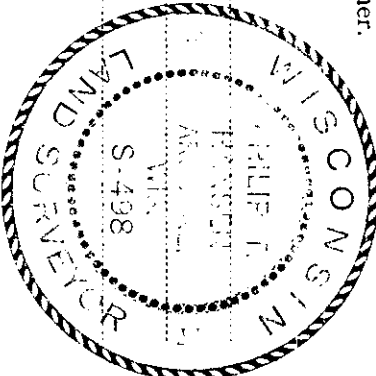

○ = Corner monument restored.

History of original corner establishment:

Original corner established by W. D. Dougherty, Deputy Surveyor, in 1953, from which corner he bears S11°W, 21 1/2' and S89°E, 21 1/2' to N10°E, 64 1/2' to S.

D. T. Vaughan, County Surveyor, recovered the original tree in 1967. Corner recovered by dissection, found Vaughan's old post and set an iron pipe in its place.

Description of corner evidence found:

Recovered from pine, 1 1/2' high, in N-S fence line which has recently been returned. There is also an old fence line which extends west from the iron pipe. This fence is down, but remains visible. No old posts recovered.

Description of monument and accessories I established to perpetuate the original location of this corner.

Set 2nd Quarter A-1 Federal Monument in 1/4 of the old 1/4. Monument projects from above ground. On standard marked posts - Made on 1/2" x 2 1/2" x 1 1/2" iron, set 1 1/4' PT. Made on 3/2" x 4 1/2" x 1 1/2" iron, set 1 1/4' PT. Made on 1/2" x 4 1/2" x 1 1/4' iron, set 1 1/4' PT. T35N R11E 23 24 1/4 25 1977

Dated at Princeton, Wis., this 12th day of October, 1977

Signature Philip T. Jensen Title Registered Land Surveyor Registration No. 2-498 County Surveyor, Registered Land Surveyor, or other duly authorized official)

Office of Register of Deeds, County of Cneida I hereby certify that the within instrument was filed in this office for record on the 19th day of November, 1977 at 2:12 o'clock P. M.

Doris Savage Thacker (Register of Deeds)

By Joseph M. Bremer Deputy

3511232000