



CERTIFIED LAND CORNER RESTORATION

Index No. 0-22

State of Wisconsin }  
 County of Oneida } ss.

I Philip T. Hansen, do hereby certify that on the 17th day of November, 1976, I found evidence of the 1776 corner of the Section 24 Township 35, North, Range 11, Fourth Principal Meridian, as described hereon; and that from this evidence I established a new monument and accessories as described hereon to perpetuate the original location of this corner.

Resident witnesses:  
Olga Hanson  
Jim Hoffman  
Harb Atomer

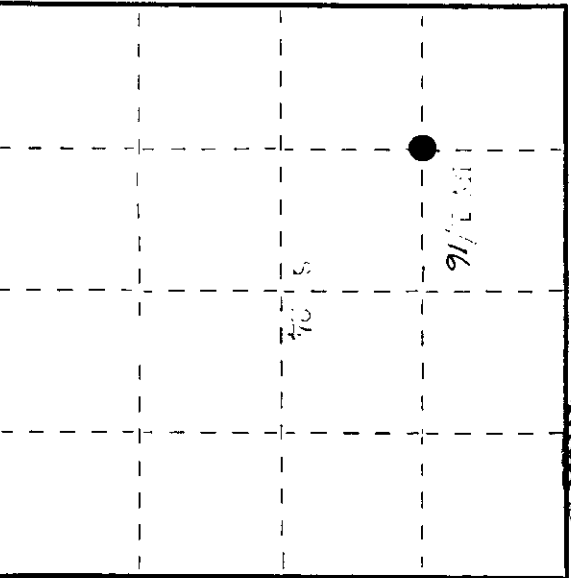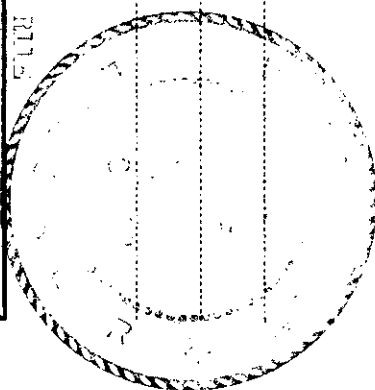

○ = Corner monument restored.

History of original corner establishment:

Corner established by O.H. Vaughan, County Surveyor, in 1907. Set post and marked pits - 1st 18" x 6" x 3 links and block set 10" x 7.5" x 3 links. Corner recovered by H.O. Lawrence, registered Land Surveyor. Recovered set - block set 10" x 7.5" x 3 links. Set new post. Elm 18" was gone. Set new post.

Description of corner evidence found:





351-1976


Signature Philip T. Hansen Title Registered Land Surveyor Registration No. 4995  
 (County Surveyor, Registered Land Surveyor, or other duly authorized official)

Office of Register of Deeds, County of Oneida, I hereby certify that the within instrument was filed in this office for record on the 9th day of December, 1976 at 2:02 o'clock P.M.

By Steve George Tuck (Register of Deeds)  
Joseph M. Bremer Deputy

351124 3030