

CERTIFIED LAND CORNER RESTORATION


Index No. 7-11

State of Wisconsin }
 County of Oneida } ss.

I, Phillip T. Hansen, do hereby certify that on the 27th day of October, 19 78, I ~~found~~ established ~~corner~~ of the C 1/4 corner of Section 28 Township 35, North, Range 11 East, Fourth Principal Meridian, as described hereon; and that from this evidence I established a new monument and accessories as described hereon to perpetuate the original location of this corner.

Resident witnesses:

Glen Barker
Jim Claflin
Herb Wagoner

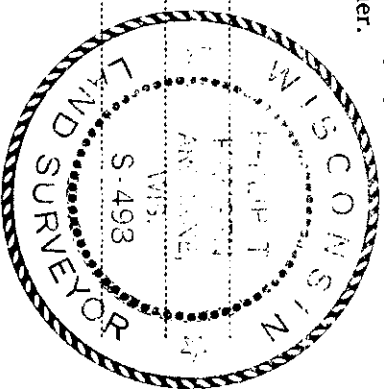


History of original corner establishment:

Description of corner evidence found:
 No evidence of any corner recovered. Corner established by traverse and computation. Ran traverse from N 1/4 to S 1/4 corner and from W 1/4 to E 1/4 corner. Established C 1/4 corner at N 4° 45' 20" E of S 1/4 corner. S 4° 45' 20" W, 2683.887 feet from N 1/4 corner, S 89° 23' 57" E 25558.545 feet of W 1/4 corner and 2955.929 feet N 89° 23' 57" W of E 1/4 corner.

Description of monument and accessories I established to perpetuate the original location of this corner.

Set 2 1/2" Berntsen A-1 Federal Monument, projecting 18" above ground. Cap stamped:

Marked NBT's -		T35N R11E
Maple 6" S78°E	17.45'	
Maple 8" N47°E	42.60'	C 1/4 S 28
Maple 6" N33°W	14.59'	
	all scribed C 1/4 BT	S498-1978

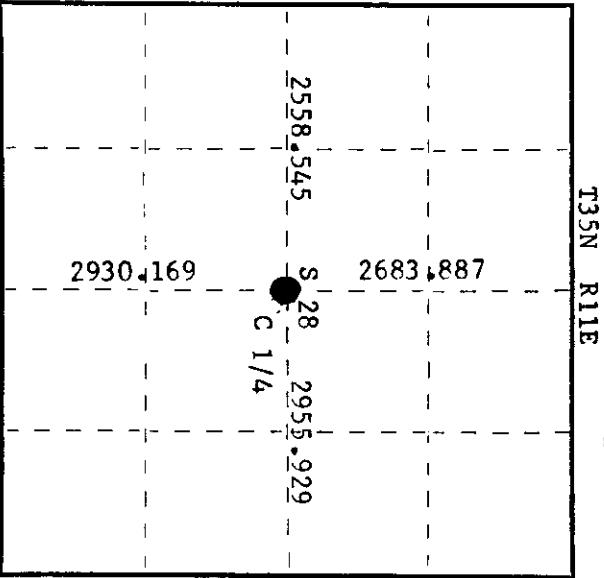

○ = Corner monument restored.

Dated at Rhinelander, Wis., this 13th day of November, 19 78

Signature Phillip T. Hansen Title Registered Land Surveyor Registration No. S-498
 (County Surveyor, Registered Land Surveyor, or other duly authorized official)

Office of Register of Deeds, County of Oneida
 Instrument was filed in this office for record on the 27th day of November, 19 78
 at 11 o'clock A. M.

Theresa George
 (Register of Deeds)

By: _____ Deputy

3511282020