

CERTIFIED LAND CORNER RESTORATION

Index No. U-5



State of Wisconsin }
County of Oneida } ss.

I Phillip T. Hansen, do hereby
certify that on the 27th day
July, 1978, I ~~found~~
~~established~~ restored the S 1/16
corner of Section 29 & 30

Township 35, North, Range
11 East, Fourth Principal Meridian,
as described hereon; and that from this evidence
I established a new monument and accessories
as described hereon to perpetuate the original
location of this corner.

Resident witnesses:

Jim Claffin
Herb Wagoner
John Masbaum

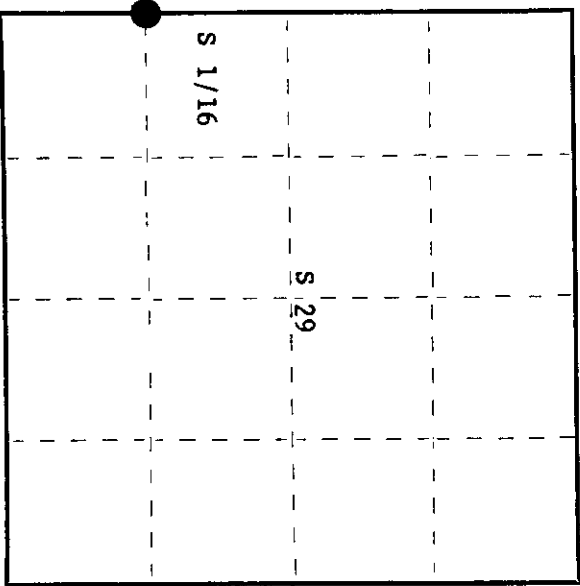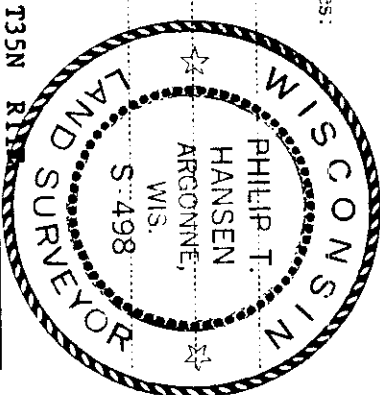

○ = Corner monument restored.

History of original corner establishment:
No records of any previous survey.

Description of corner evidence found:

No evidence of any corner recovered.

Corner established by traverse and computations. From previously established 1/4 corner
between sections 29 & 30, ran traverse to section corner 29, 30, 31 and 32. Computed
distance 2634.006 feet at bearing S 0° 26' 49" W.
Set S 1/16 corner at 1317.003 feet intermediate.

Description of monument and accessories I established to perpetuate the original location of this corner.

Set a 1 1/2" iron pipe with 2" brass cap projecting 24", stamped:

Marked NBR's - Maple 5" S54°W 40.12 feet S498
Maple 6" S4°W 50.54 feet T35N R11E
scribed 1/16 BT. S 1/16 S30 + S29
CPI-1978

Dated at Rhineland, Wis., this 7th day of August, 1978.

Signature Phillip T. Hansen Title Registered Land Surveyor Registration No. S-498
(County Surveyor, Registered Land Surveyor, or other duly authorized official)

Office of Registrar of Deeds, County of Oneida hereby certify that the within
instrument was filed in this office for record on the 18th day of September, 1978
at 10⁰⁰ o'clock P. M.

Dennis George Fischer
(Register of Deeds)

By _____ Deputy

3511301000