

CERTIFIED LAND CORNER RESTORATION

Index No. **Z-13**



State of Wisconsin

County of Oneida } ss.

I, Philip T. Hansen, do hereby certify that on the 7th day of April, 1976, I found evidence of the section corner of Sec. 33-34 - 4 and 3 Township 35-34 North, Range 11 East, Fourth Principal Meridian, as described hereon; and that from this evidence I established a new monument and accessories as described hereon to perpetuate the original location of this corner.

Resident witnesses:

- Glen Barker
- Jim Clarlin
- Herb Wagoner

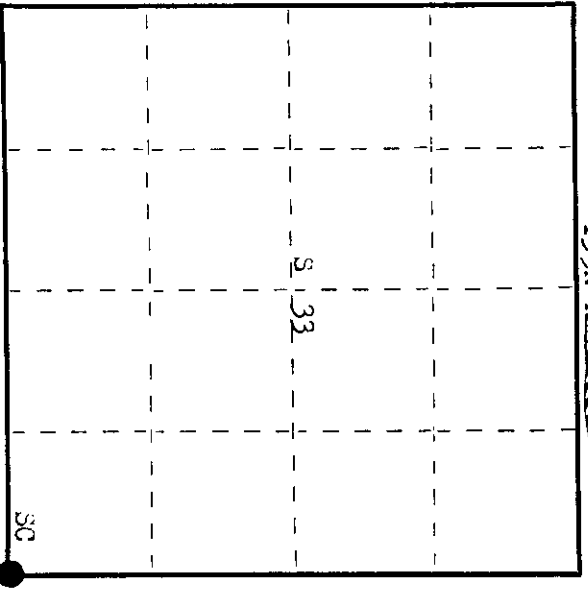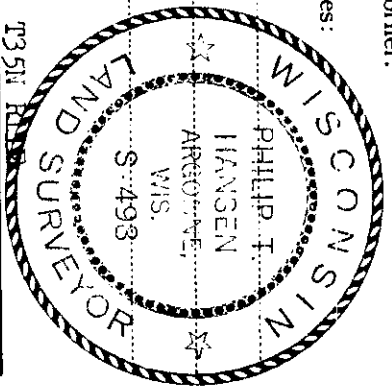

○ = Corner monument restored.

History of original corner establishment: Original corner established by Hiram C. Fellows, Deputy Surveyor, in 1859, from which hemlock 10" bears N10° 35' 1ks, W. Birch 12" bears N60° 35' 1ks, hemlock 8" bears S20° W 16' 1ks and birch 10" bears S26° W 20' 1ks.
 H.C. Lawrence, Registered Land Surveyor, recovered an old charred post in 1948. Also recovered N. Pine stp. 24" N48° W 16' 1ks, N. Pine stump 22" N84° E 17 1/2' 1ks, W. Pine stump 12" N25° W 19 1/2' 1ks and W. Pine stump 22" N60° W 22 1/2' 1ks.
 Set new cedar post 4" and marked NBTs - W. Birch 7" N23° W, 33 1/2' 1ks, W. Ash 6" S30° E 30' 1ks.

Description of corner evidence found: Recovered 4" squared cedar post, scribed S3, S4, S33, S34 in good condition. Rock cairn had been built around base. Also recovered an old well point beside wood post.

- Recovered OBTs - W. Pine stump 24" N48° W 16 1/2' 1ks - fire charred.
- W. Pine stump 22" N84° W 17 1/2' 1ks - fire charred.
- N. Pine stump 12" N25° W 19 1/2' 1ks - fire charred.
- W. Pine stump 22" N60° W 22.5' 1ks - fire charred.
- W. Birch 7" (10") N23° W, 33.5' 1ks, scribed S33 BT.
- W. Ash 6" (7") S30° E 30' 1ks, scribing grown over,

Description of monument and accessories I established to perpetuate the original location of this corner.
 Replaced post with 2 1/2" iron pipe with brass cap stamped.
 Pipe projects 18" above ground.
 NBTs Sugar Maple 8" S32° W 86.2' 1ks, scribed SC BT.
 Sugar Maple 6" S50° W 103.3' 1ks, scribed SC BT.
 Replaced rock cairn around base of monument.
 Monument and BTs painted blue.

S498
 T35N R11E
 33 | 34
 4 | 3
 T34N R11E
 1976

Dated at Rhinelander, Wis., this 14th day of May, 1976.

Signature Philip T. Hansen Title Registered Land Surveyor Registration No. 5498
 County Surveyor, Registered Land Surveyor, or other duly authorized official

Office of Register of Deeds, County of Oneida, I hereby certify that the within instrument was filed in this office for record on the 3rd day of August, 1976 at 10:30 o'clock A. M.

Donna Savage Kuhn
 (Register of Deeds)

By _____ Deputy