

CERTIFIED LAND CORNER RESTORATION

Index No. **Z-22**

State of Wisconsin } ss.

County of **Oneida**

I **Phillip T. Hansen**, do hereby certify that on the **18th** day of **November**, 19 **76**, I found evidence of the **W 1/16** corner of **Section 36 and 1** Township **35 & 34**, North, Range **11 East**, Fourth Principal Meridian,



as described hereon; and that from this evidence I established a new monument and accessories as described hereon to perpetuate the original location of this corner.

Resident witnesses:

**Glen Barker**

**Jim Clarin**

**Herb Wagoner**

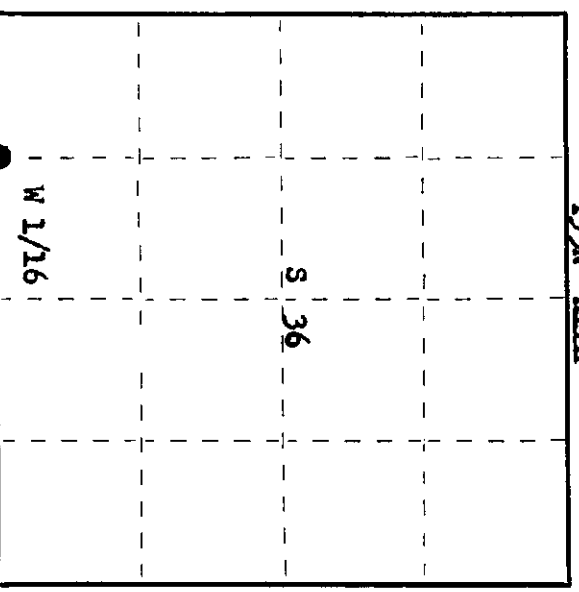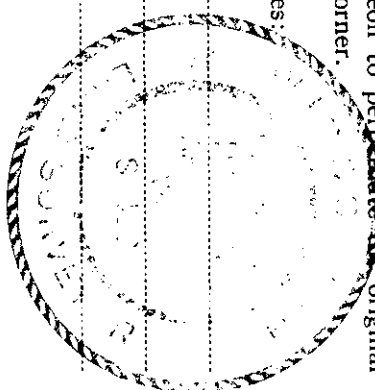

○ = Corner monument restored.

History of original corner establishment:

Corner recovered by H.C. Lawrence, Registered Land Surveyor. Records indicate he found an old post and an old BT while running the line west from 1/4 corner. Set a new 3" oak post and marked NBT - Basswood 11" S 37° E 53 links and oak 12" N 17° W 27 1/2 links.

Description of corner evidence found:

Recovered Lawrence's 3" oak post, squared and scribed W 1/16 S1, W 1/16 S36, laying on ground. Recovered point of post.  
Recovered OBT - basswood 11" (13") S 37° E 53 links, scribing partly visible.  
Oak 12" (16") N 17° W 27.5 links, scribing grown over.

Description of monument and accessories I established to perpetuate the original location of this corner.

Replaced point of oak post with 1 1/2" iron pipe with brass cap stamped:  
Monument projects 18" above ground. S4,98  
T35N R11E  
Placed rock cairn around base.  
NBT - Sugar 6" S 52° E 19.5 links, scribed 1/16 BT. W 1/16 S1 36  
Corner sets 15 links south of an old E-W county line road. T34N R11E

Dated at **Rhinelander**, Wis., this **6th** day of **December**, 19 **76**

Signature *Phillip T. Hansen* Title **Registered Land Surveyor** Registration No. **S-4,98**  
County Surveyor, Registered Land Surveyor, or other duly authorized official)

Office of Register of Deeds, County of **Oneida**  
Instrument was filed in this office for record on the **20th** day of **December**, 19 **76**  
at **1:00** o'clock **P**. M.

*David George Hecker*  
(Register of Deeds)

By \_\_\_\_\_ Deputy

0 11 36 00 20